


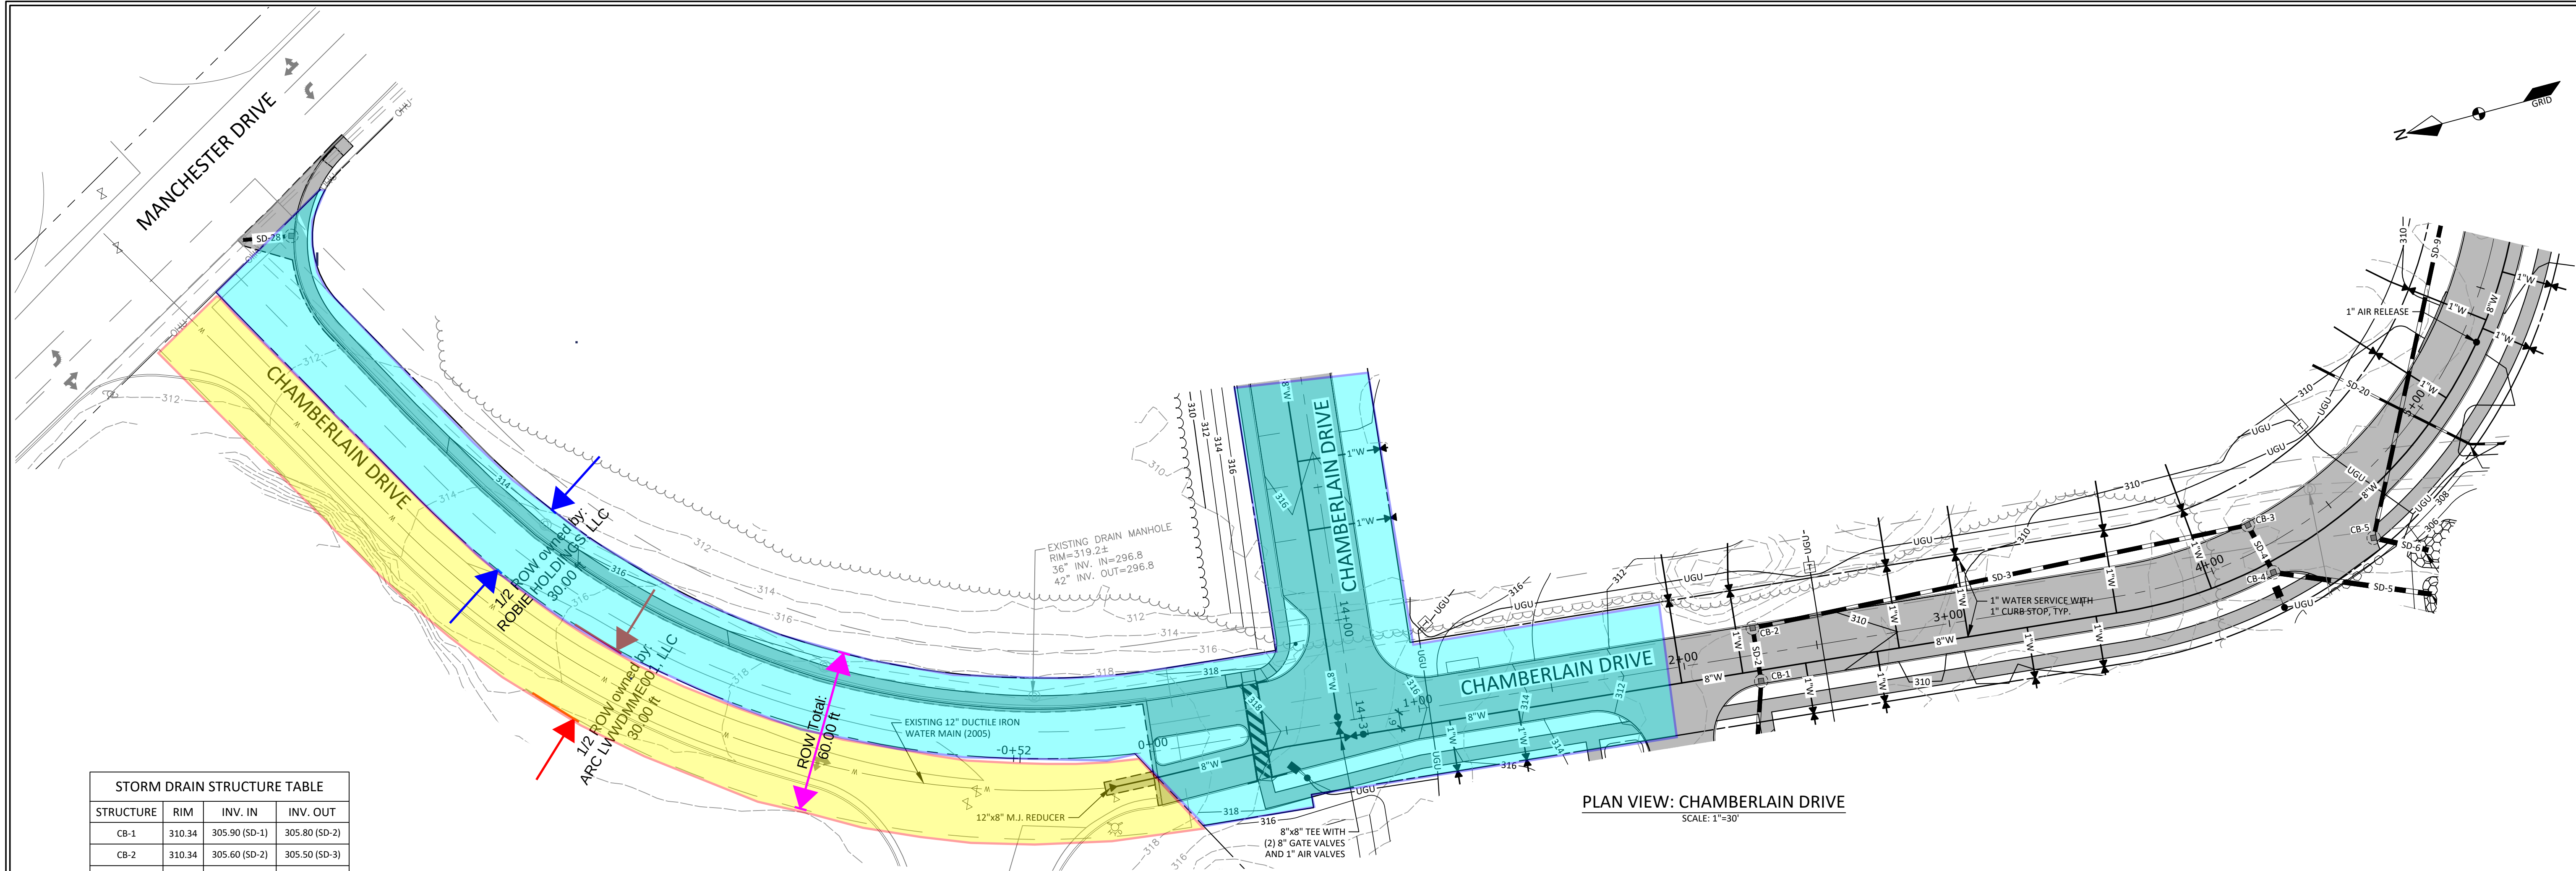

PLAN VIEW: CHAMBERLAIN DRIVE

SCALE: 1"=30'

STORM DRAIN STRUCTURE TABLE

STRUCTURE	RIM	INV. IN	INV. OUT
CB-1	310.34	305.90 (SD-1)	305.80 (SD-2)
CB-2	310.34	305.60 (SD-2)	305.50 (SD-3)
CB-3	308.55	304.60 (SD-3)	304.50 (SD-4)
CB-4	308.55	304.35 (SD-4)	304.25 (SD-5)
CB-5	308.75	304.00 (SD-9)	303.90 (SD-6)
CB-6	308.87	305.00 (SD-8)	304.90 (SD-9)
CB-7	308.87		305.10 (SD-10)
CB-8	311.20	307.20 (SD-12)	307.10 (SD-11)
CB-9	312.01	308.05 (SD-13)	307.95 (SD-12)
CB-10	312.01	308.05 (SD-14)	
CB-11	312.88	308.60 (SD-17)	308.50 (SD-14)
CB-12	312.22	308.95 (SD-16)	308.85 (SD-15)
CB-13	312.22		309.05 (SD-16)
CB-14	314.88	310.45 (SD-18)	310.35 (SD-17)
CB-15	314.88	310.60 (SD-18)	
CB-16	310.50		306.50 (SD-28)
FI-1	309.35		306.35 (SD-7)
FI-2	308.70	305.70 (SD-7)	305.70 (SD-8)
OCS-1	304.80	300.33 (UD-1)	300.23 (SD-29)

STORM DRAIN PIPE TABLE

NAME	SIZE	LENGTH	SLOPE
SD-1	15"	96'	2.88%
SD-2	15"	20'	1.25%
SD-3	15"	188'	0.49%
SD-4	18"	20'	0.94%
SD-5	18"	59'	0.78%
SD-6	18"	21'	0.53%
SD-7	12"	120'	0.55%
SD-8	12"	137'	0.52%
SD-9	15"	174'	0.53%
SD-10	15"	20'	0.62%
SD-11	15"	123'	0.49%
SD-12	15"	155'	0.50%
SD-13	15"	20'	1.25%
SD-14	15"	96'	0.49%
SD-15	15"	46'	0.59%
SD-16	15"	20'	0.62%
SD-17	15"	192'	0.93%

STORM DRAIN PIPE TABLE

NAME	SIZE	LENGTH	SLOPE
SD-18	15"	20'	0.94%
SD-19	8"	128'	1.03%
SD-20	8"	94'	1.00%
SD-21	8"	234'	1.00%
SD-22	6"	69'	0.94%
SD-23	8"	168'	1.00%
SD-24	8"	87'	1.00%
SD-25	8"	111'	1.00%
SD-26	6"	60'	0.99%
SD-27	6"	46'	0.98%
SD-28	12"	18'	1.25%
SD-29	12"	26'	0.40%
SD-30	15"	124'	0.45%
SD-32	30"	68'	0.51%
SD-33	30"	126'	0.52%
UD-1	4"	11'	0.00%



LEGEND

EXISTING PROPOSED

---	PROPERTY LINE/R.O.W.	---	PROPERTY LINE/R.O.W.
---	ABUTTER PROPERTY LINE	---	ABUTTER PROPERTY LINE
---	EASEMENT LINE	---	EASEMENT LINE
---	CENTERLINE	---	CENTERLINE
---	BUILDING	---	BUILDING
---	EDGE OF PAVEMENT/CURB	---	EDGE OF PAVEMENT/CURB
---	EDGE OF GRAVEL	---	EDGE OF GRAVEL
---	SIGN	---	SIGN
---	CONTOUR LINE	---	CONTOUR LINE
---	TREELINE	---	TREELINE
---	TEST PIT	---	TEST PIT
---	CATCHBASIN	---	CATCHBASIN
---	DRAINAGE MANHOLE	---	DRAINAGE MANHOLE
---	CULVERT/STORMDRAIN	---	CULVERT/STORMDRAIN
---	UNDERDRAIN	---	UNDERDRAIN
---	SANITARY SEWER PIPE	---	SANITARY SEWER PIPE
---	WATER MAIN	---	WATER MAIN
---	WATER VALVE	---	WATER VALVE
---	HYDRANT	---	HYDRANT
---	AIR RELEASE	---	AIR RELEASE
---	UTILITY POLE	---	UTILITY POLE
---	OVERHEAD UTILITIES	---	OVERHEAD UTILITIES
---	UNDERGROUND UTILITIES	---	UNDERGROUND UTILITIES
---	TRANSFORMER PAD	---	TRANSFORMER PAD
---	RIPRAP	---	RIPRAP
---	SILT FENCE	---	SILT FENCE


AS-BUILT NOTES:

1. BASE PLAN INFORMATION FROM PLANS PREPARED BY DM ROMA CONSULTING ENGINEERS.
2. AS-BUILT INFORMATION IS BASED ON CONSTRUCTION NOTES PROVIDED BY SITE CONTRACTOR. ANY DEVIATIONS FROM DESIGN PLANS AS NOTED BY SITE CONTRACTOR ARE SHOWN IN RED.

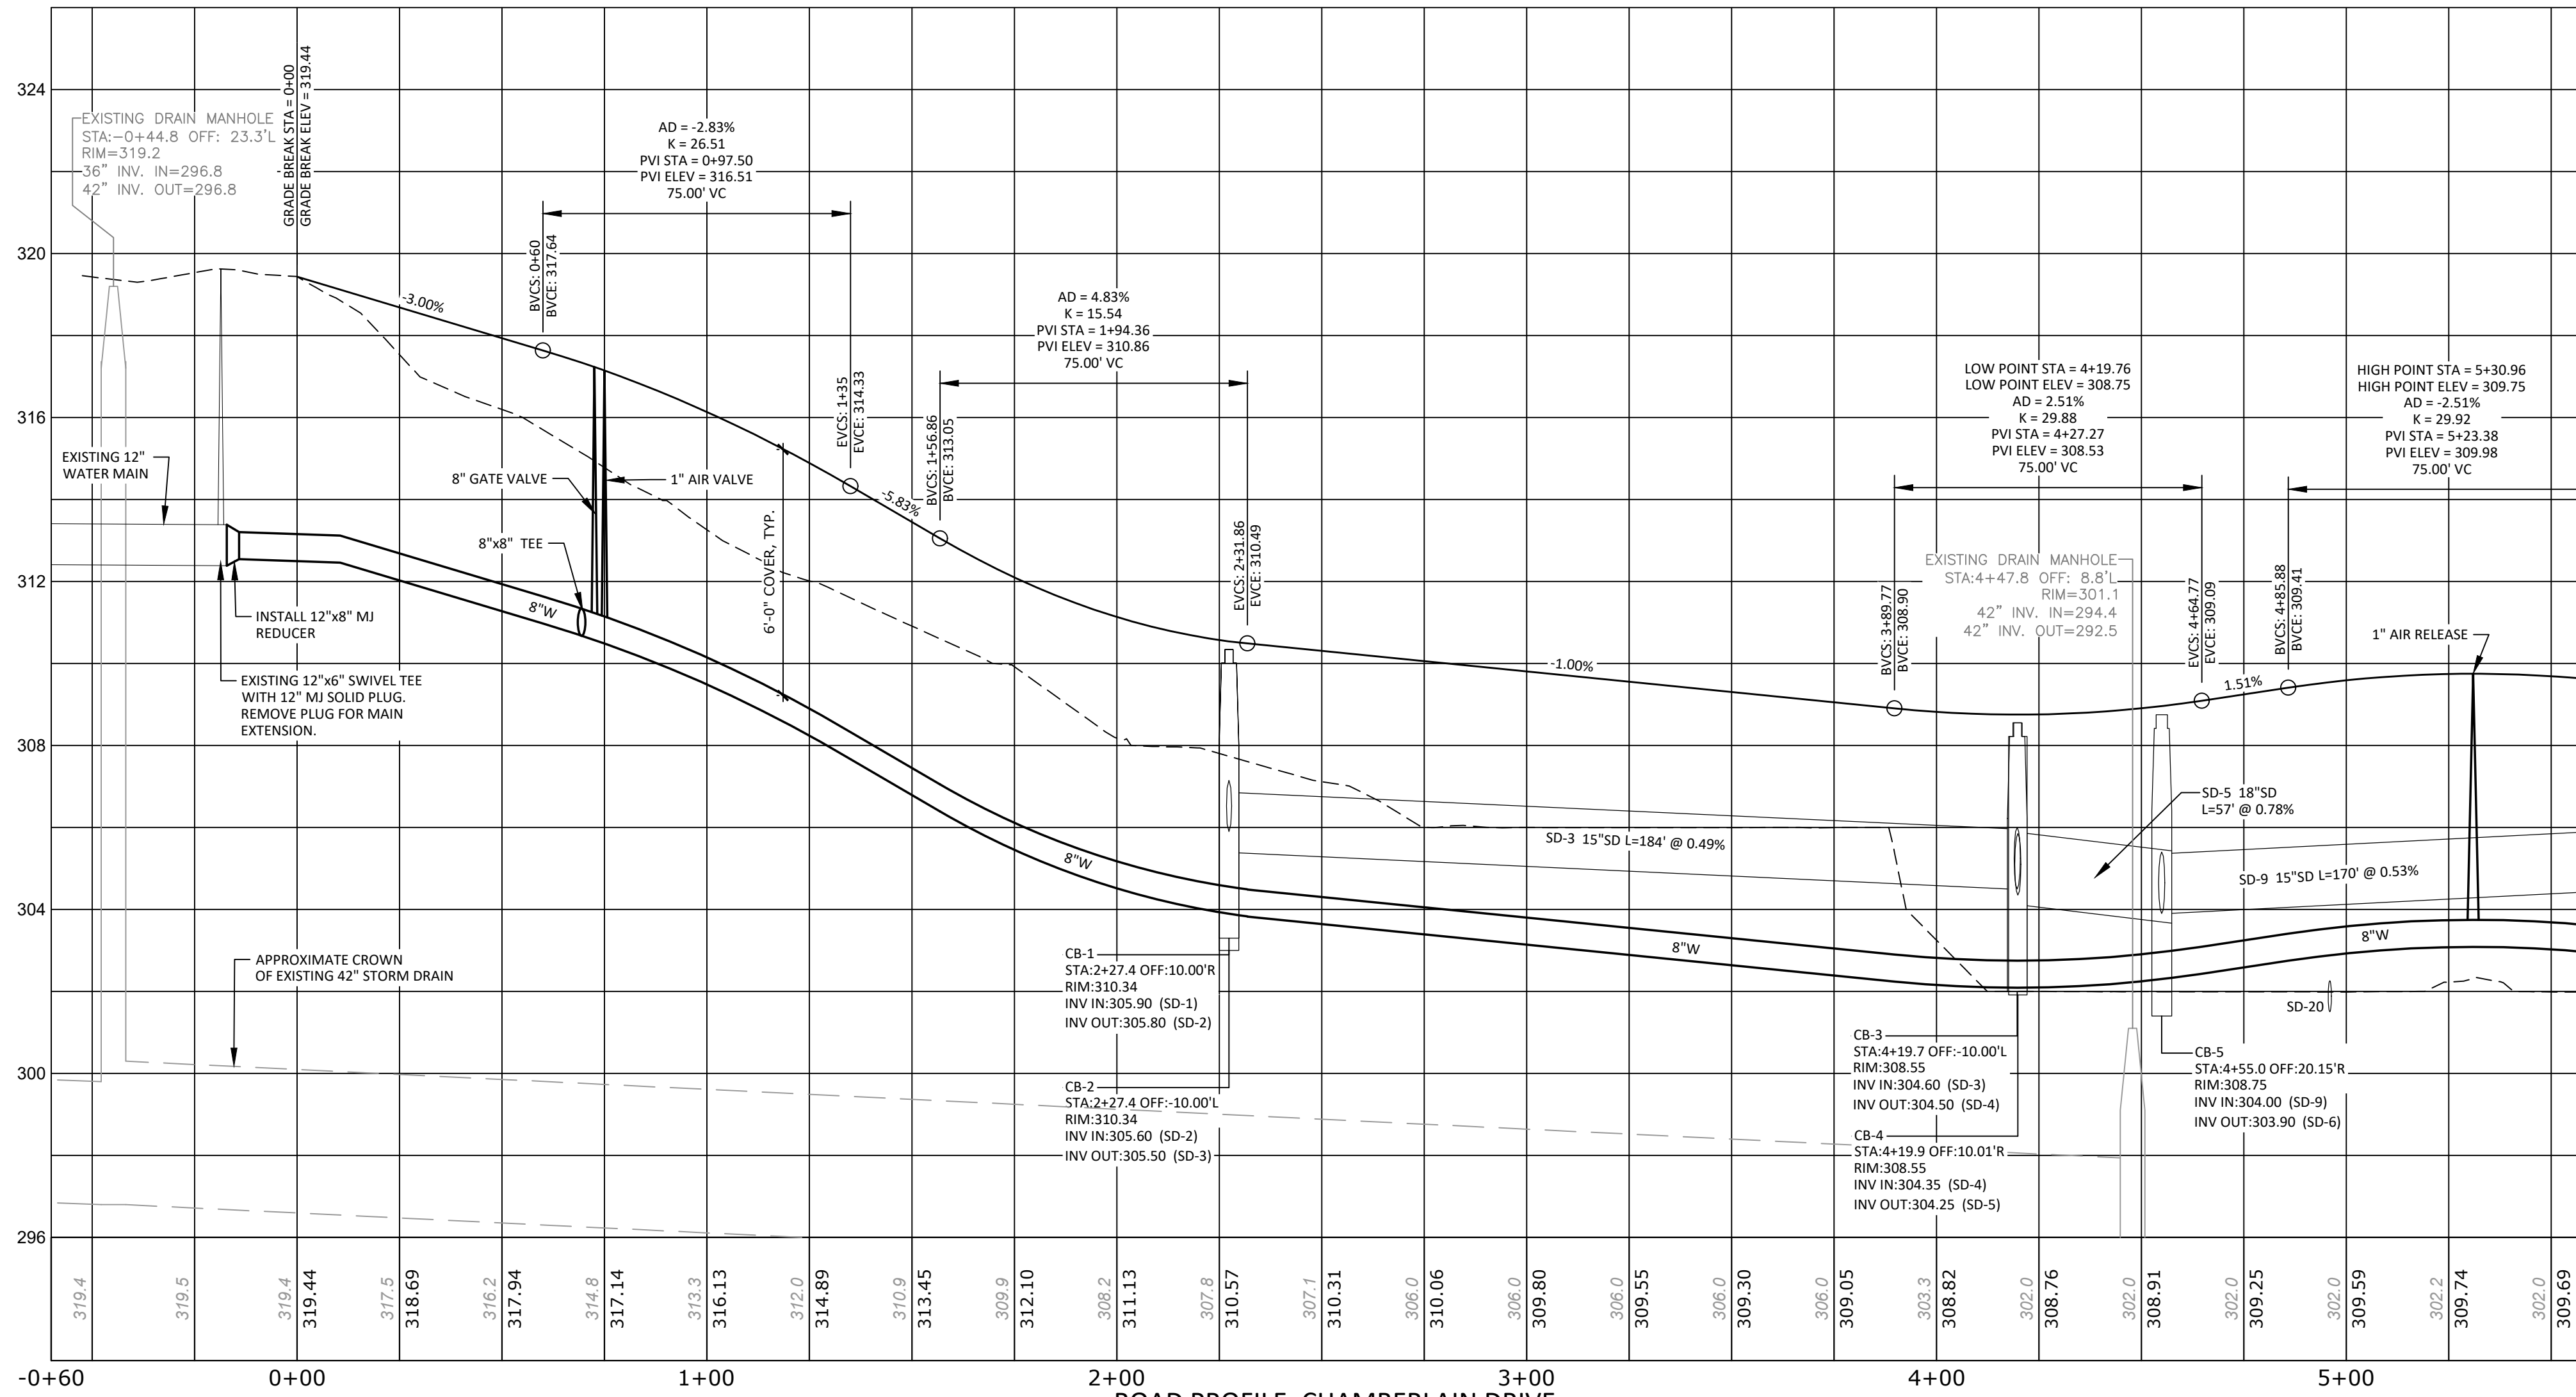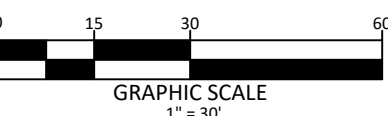

ROAD PROFILE: CHAMBERLAIN DRIVE

SCALE: HORIZ: 1"=30'
VERT: 1"=3'

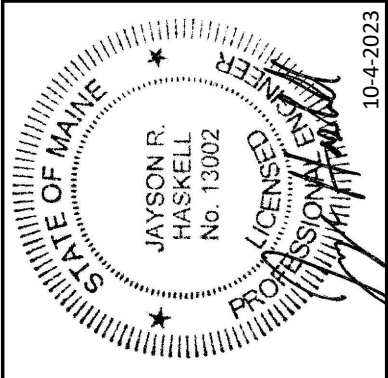

DM ROMA
CONSULTING ENGINEERS

P.O. BOX 1116
WINDHAM, ME 04062
(207) 310-0506

REV	DATE	BY	DESCRIPTION
A	10-4-23	JRH	AS-BUILT PLANS

AS-BUILT: CHAMBERLAIN DRIVE

CHAMBERLAIN ESTATES

MANCHESTER DRIVE
WINDHAM, MAINE

FOR: **ROBIE HOLDINGS, LLC**

P.O. BOX 1508
WINDHAM, ME 04062

20039
JOB NUMBER:
AS NOTED
SCALE:
10-4-2023
DATE:
SHEET 1 OF 4
PP-1