




# SEBAGO HEIGHTS SUBDIVISION PHASE 5 AS-BUILT PLANS

HARVEST HILL ROAD  
WINDHAM, MAINE  
NOVEMBER 20, 2017



| AS-BUILT DRAWING SHEET INDEX |                                 |
|------------------------------|---------------------------------|
| PAGE NO.                     | DESCRIPTION                     |
| 1                            | TITLE SHEET                     |
| 2                            | AS-BUILT PLAN HARVEST HILL ROAD |
| 3                            | AS-BUILT PLAN HARVEST HILL ROAD |
| 4                            | AS-BUILT PLAN MONUMENTATION     |

INDEX MAP

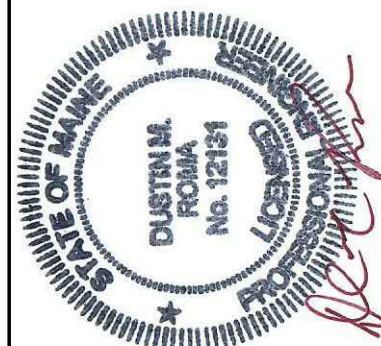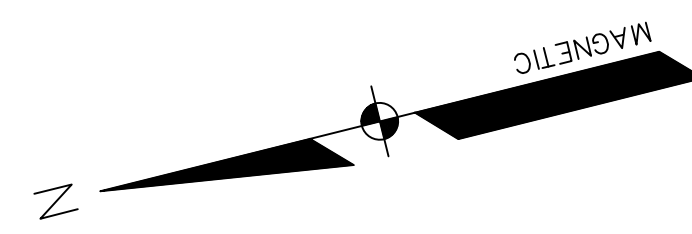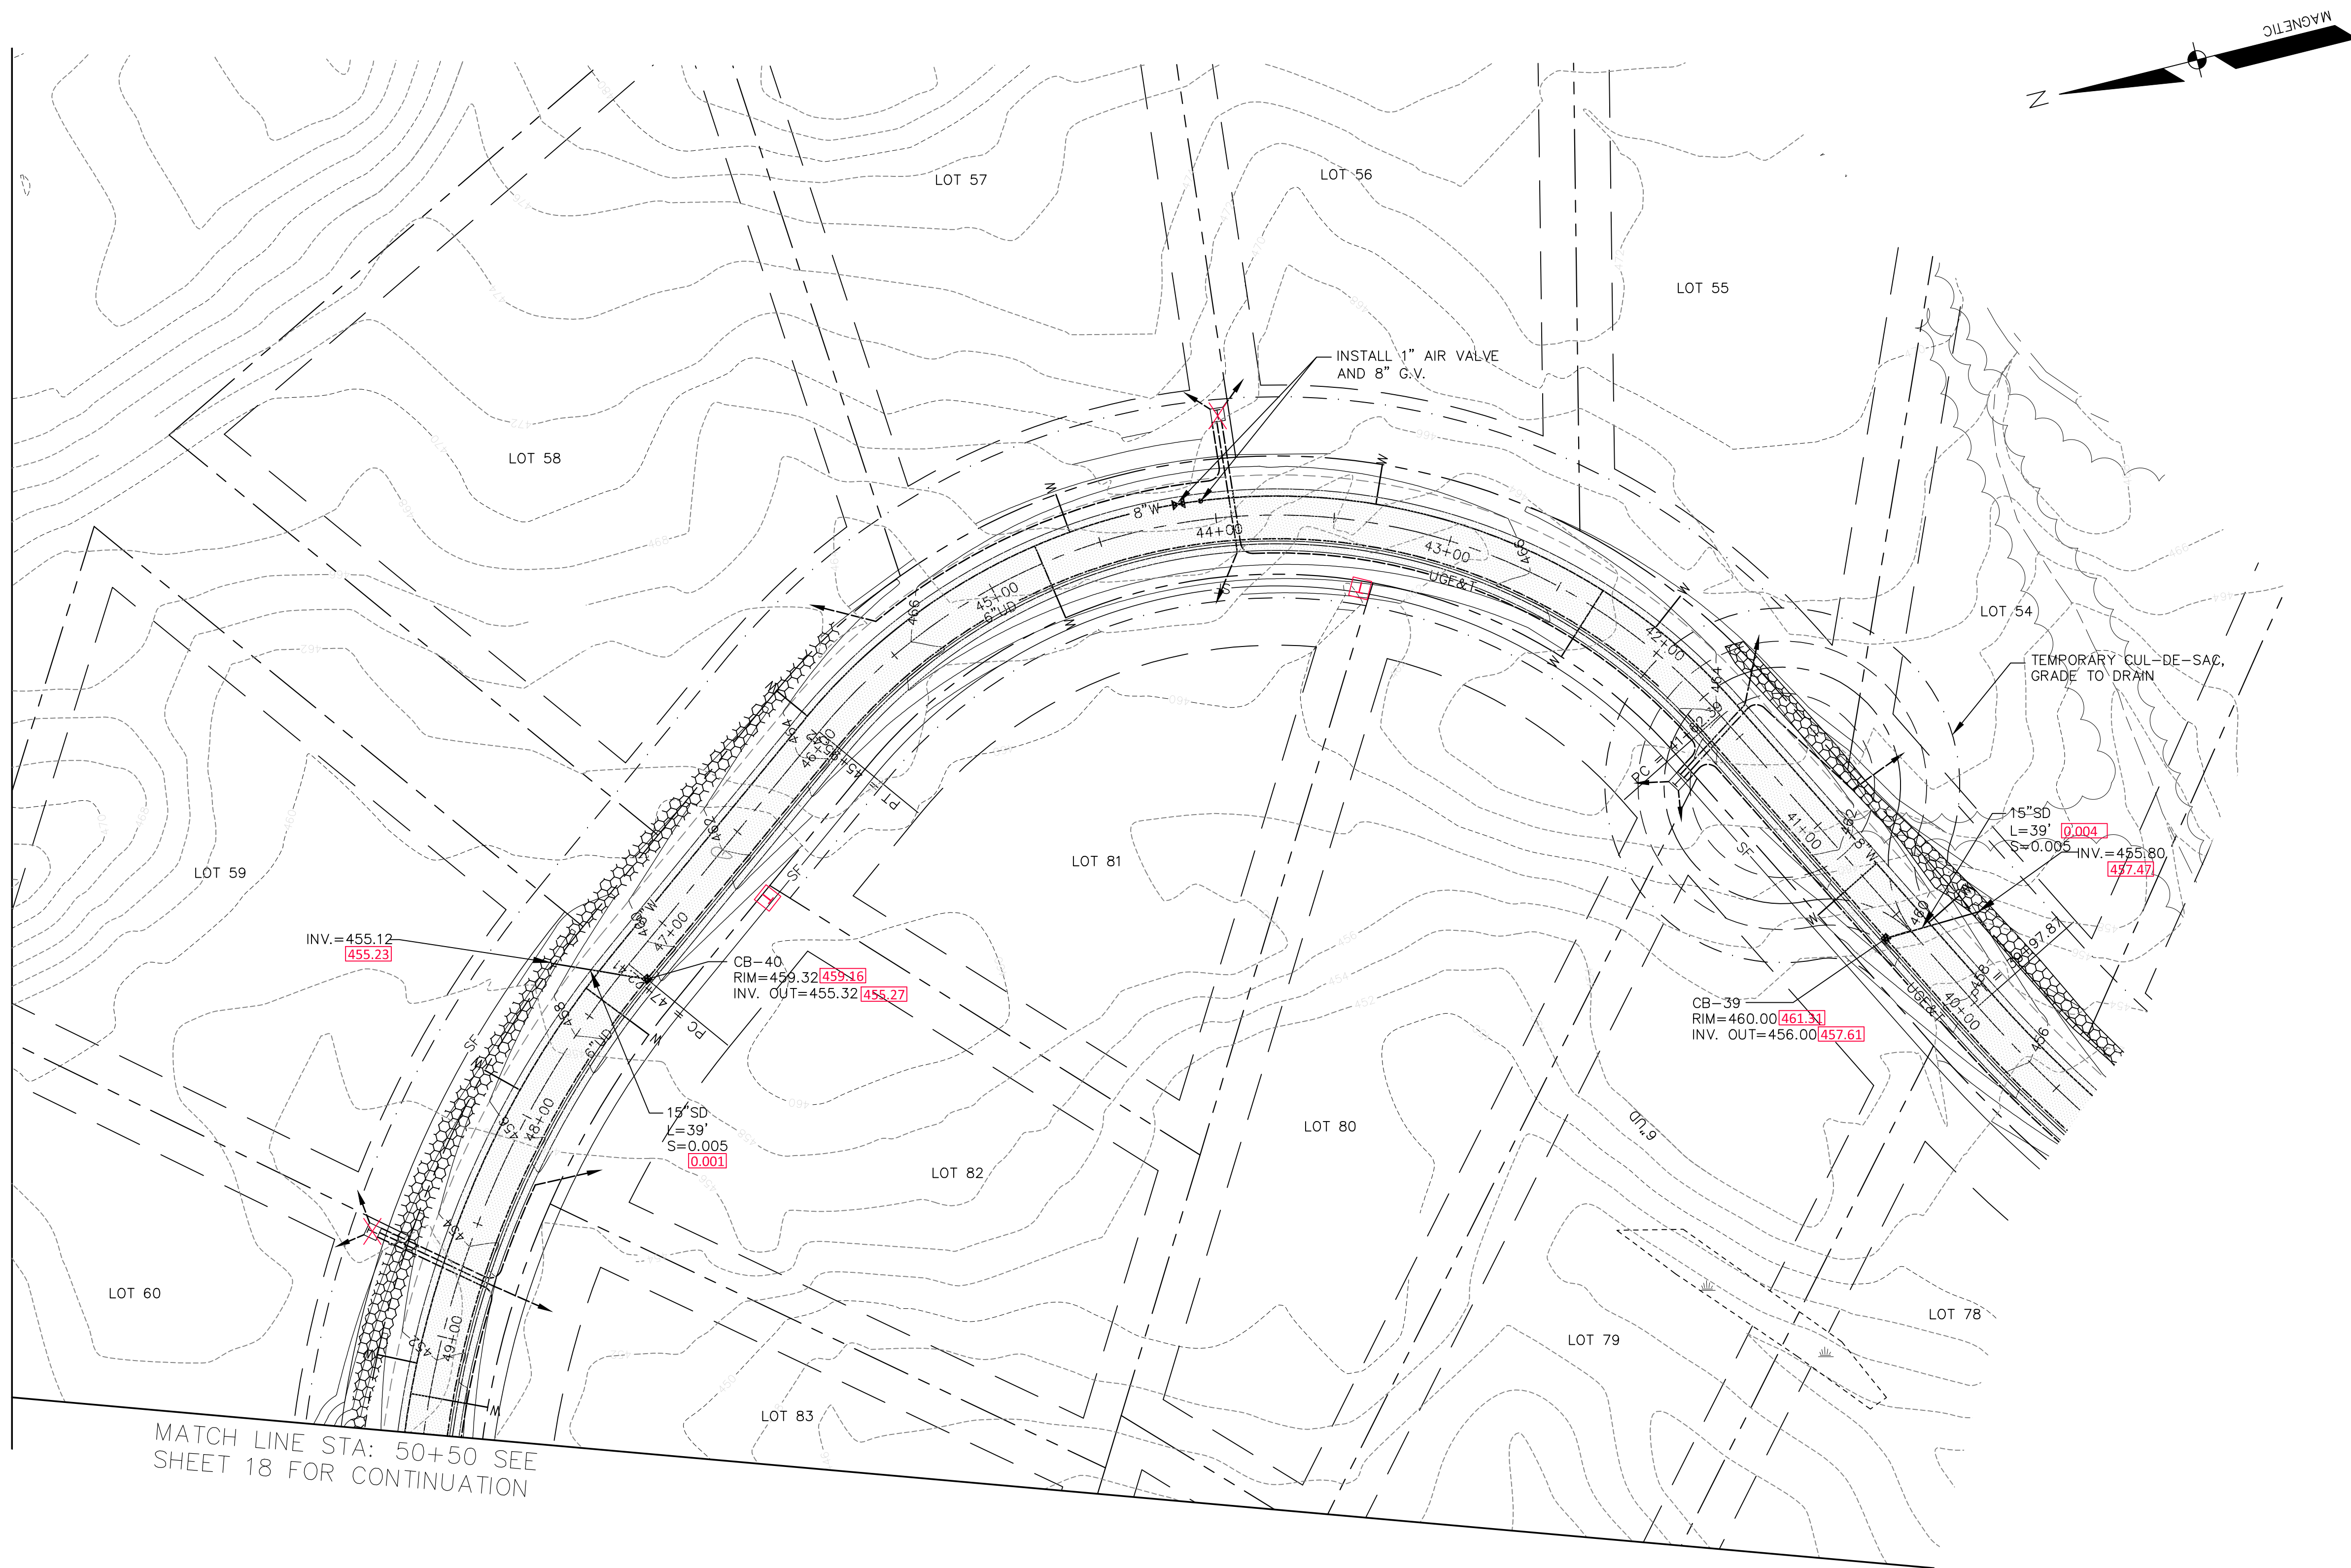

**DM ROMA**  
CONSULTING ENGINEERS  
59 HARVEST HILL RD  
WINDHAM, ME 04062  
(207) 310-0506


| REV | DATE | BY | DESCRIPTION |
|-----|------|----|-------------|
|     |      |    |             |
|     |      |    |             |
**AS-BUILT PLAN**  
SEBAGO HEIGHTS SUBDIVISION - PHASE 5  
WINDHAM, MAINE  
FOR RECORD OWNER:  
SEBAGO HEIGHTS, LLC  
97A EXCHANGE STREET  
PORTLAND, ME 04101

15012  
JOB NUMBER:  
1" = 40'  
SCALE:  
11-20-2017  
DATE:  
SHEET 2 OF 4  
AB-2

AS-BUILT PLAN NOTES:


1. BASE PLAN INFORMATION FROM PLANS PREPARED BY SEBAGO TECHNICS, INC.
2. AS-BUILT INFORMATION SHOWN HEREON BASED SOLELY ON CONTRACTOR'S NOTES PROVIDED BY R.J. GRONDIN & SONS.

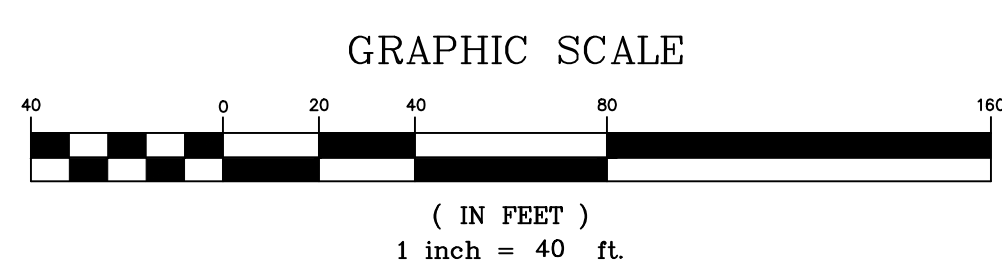

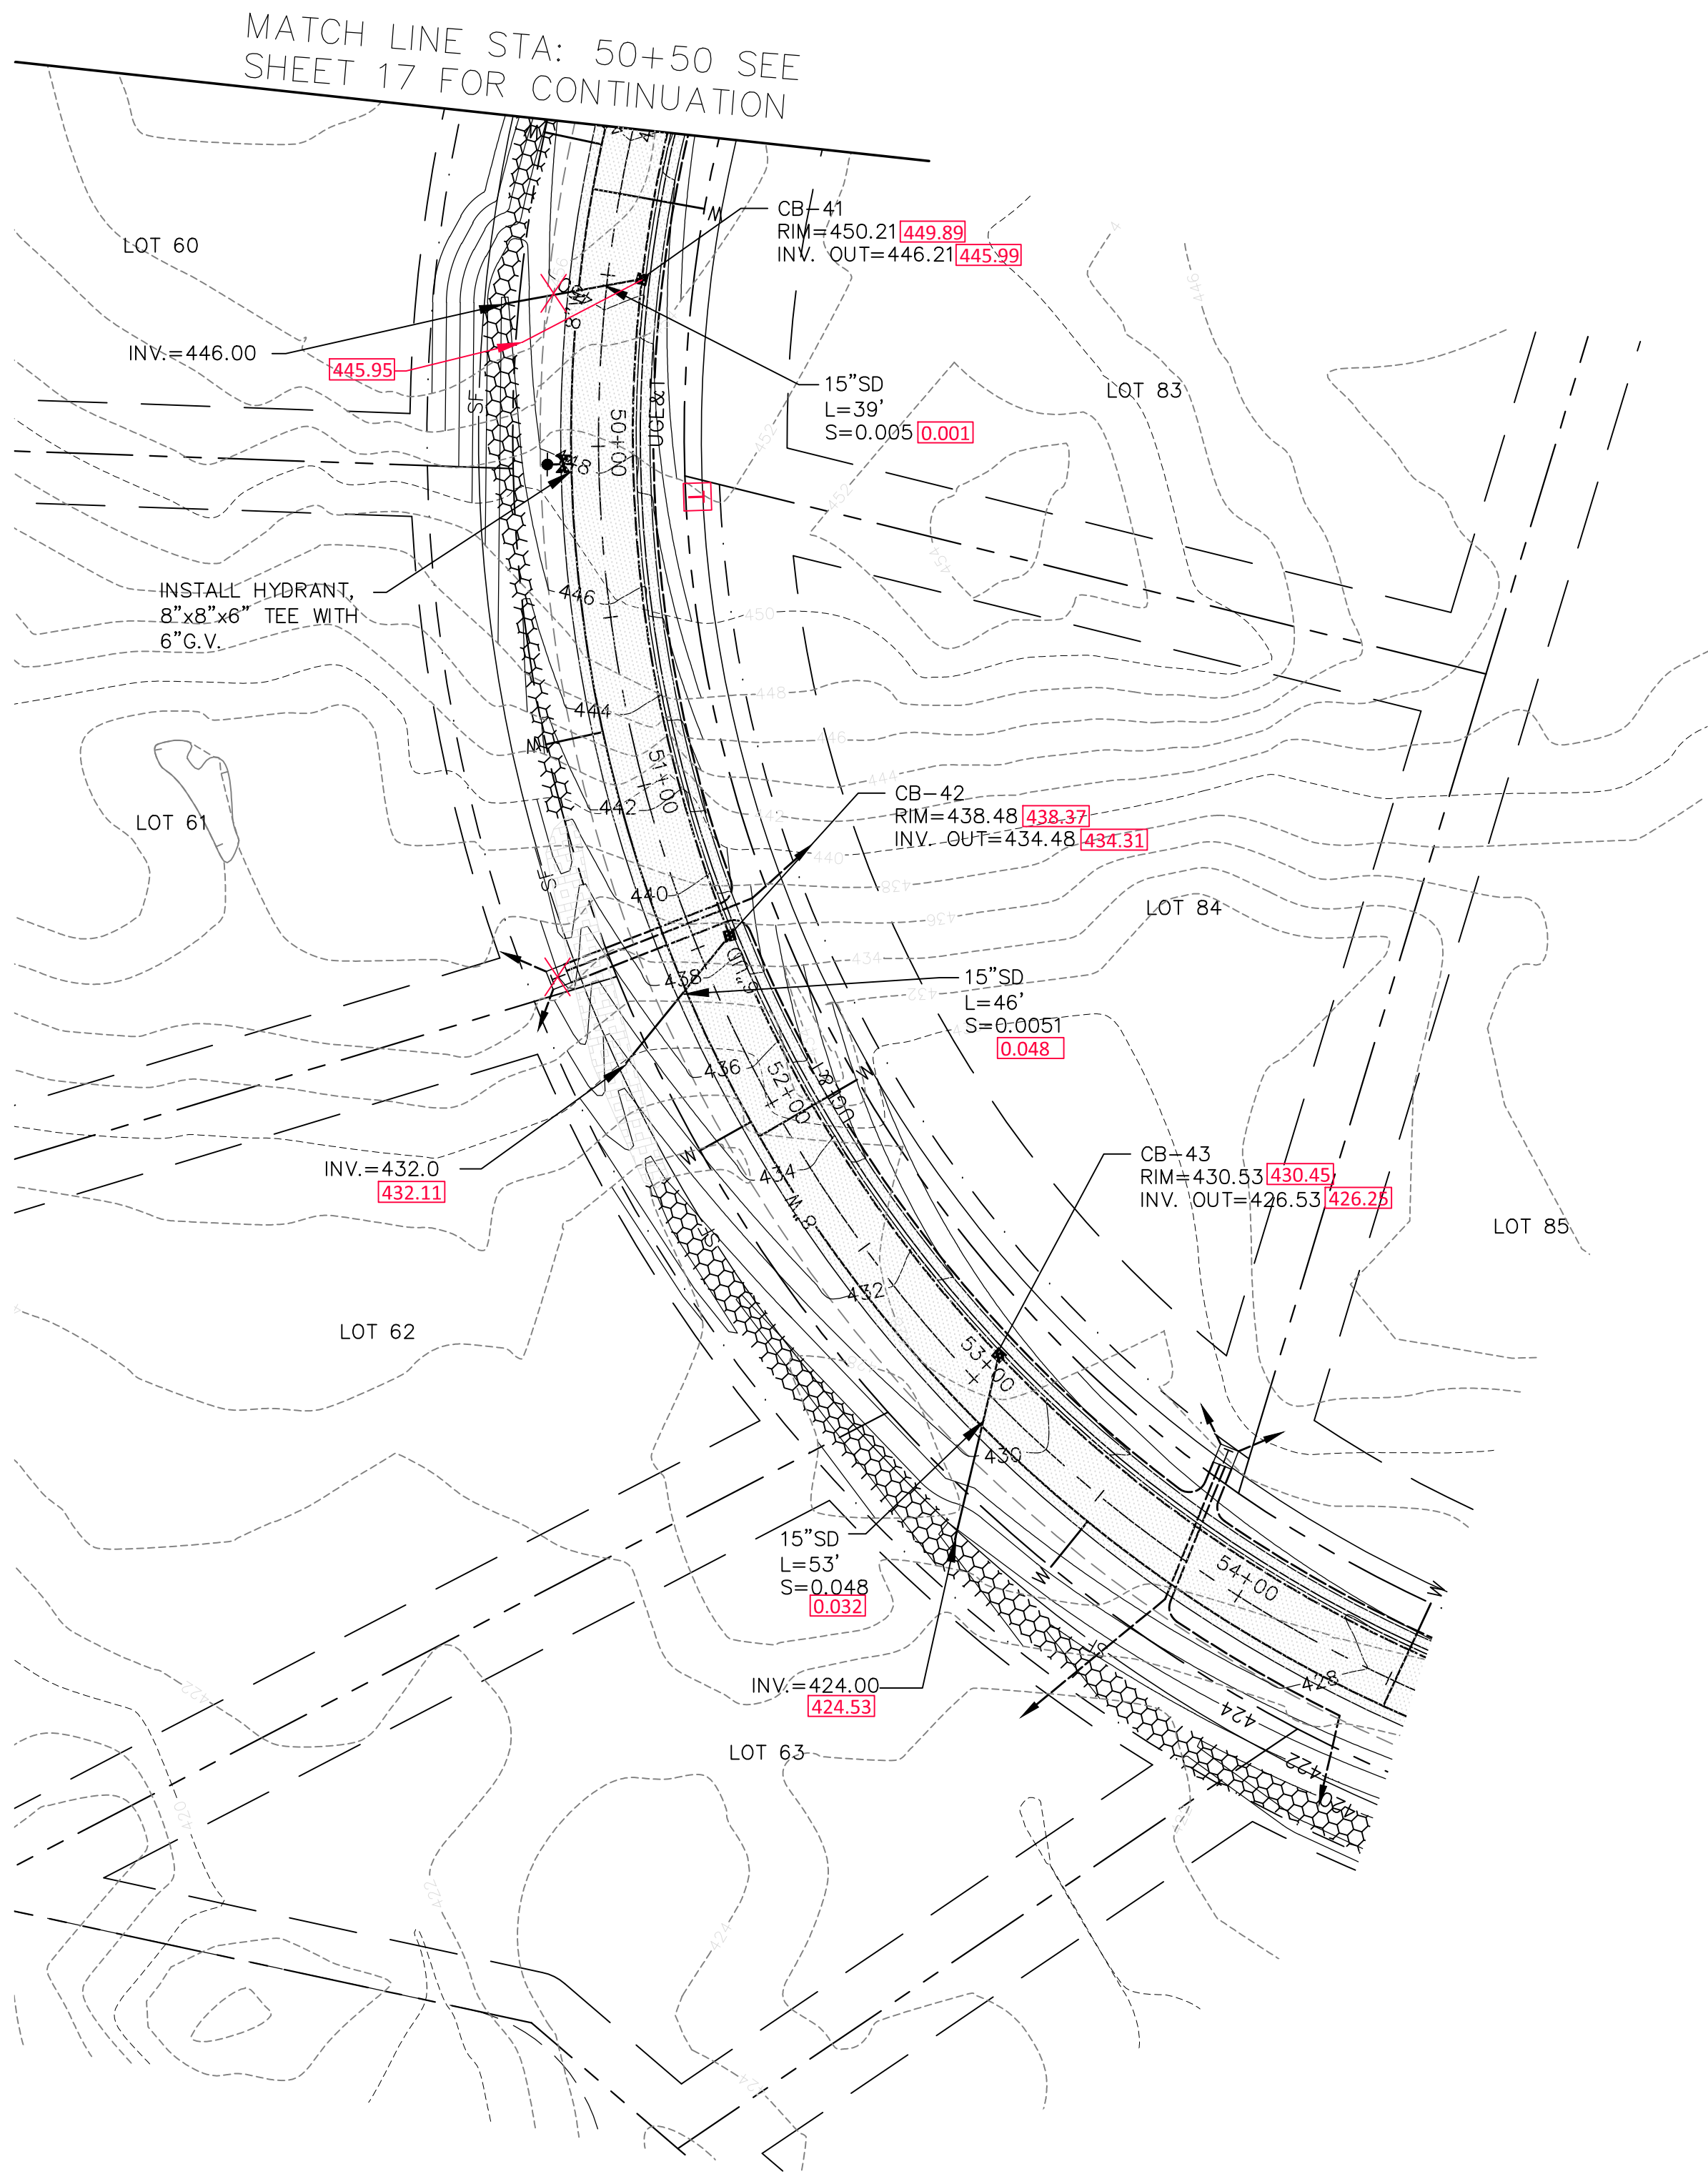

AS-BUILT PLAN NOTES:

1. BASE PLAN INFORMATION FROM PLANS PREPARED BY SEBAGO TECHNICS, INC.
2. AS-BUILT INFORMATION SHOWN HEREON BASED SOLELY ON CONTRACTOR'S NOTES PROVIDED BY R.J. GRONDIN & SONS.

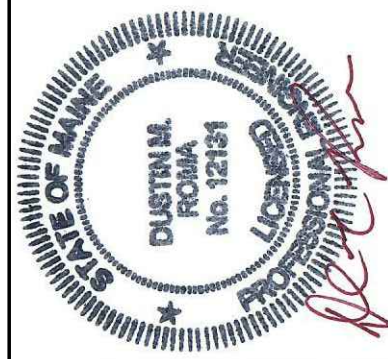


**DM ROMA**  
CONSULTING ENGINEERS  
59 HARVEST HILL RD  
WINDHAM, ME 04062  
(207) 310 - 0506

| REV | DATE | BY | DESCRIPTION |
|-----|------|----|-------------|
|     |      |    |             |
|     |      |    |             |
**AS-BUILT PLAN**  
SEBAGO HEIGHTS SUBDIVISION - PHASE 5  
WINDHAM, MAINE  
FOR RECORD OWNER:  
SEBAGO HEIGHTS, LLC  
97A EXCHANGE STREET  
PORTLAND, ME 04101

15012  
JOB NUMBER:  
1" = 40'  
SCALE:  
11-20-2017  
DATE:  
SHEET 3 OF 4  
AB-3

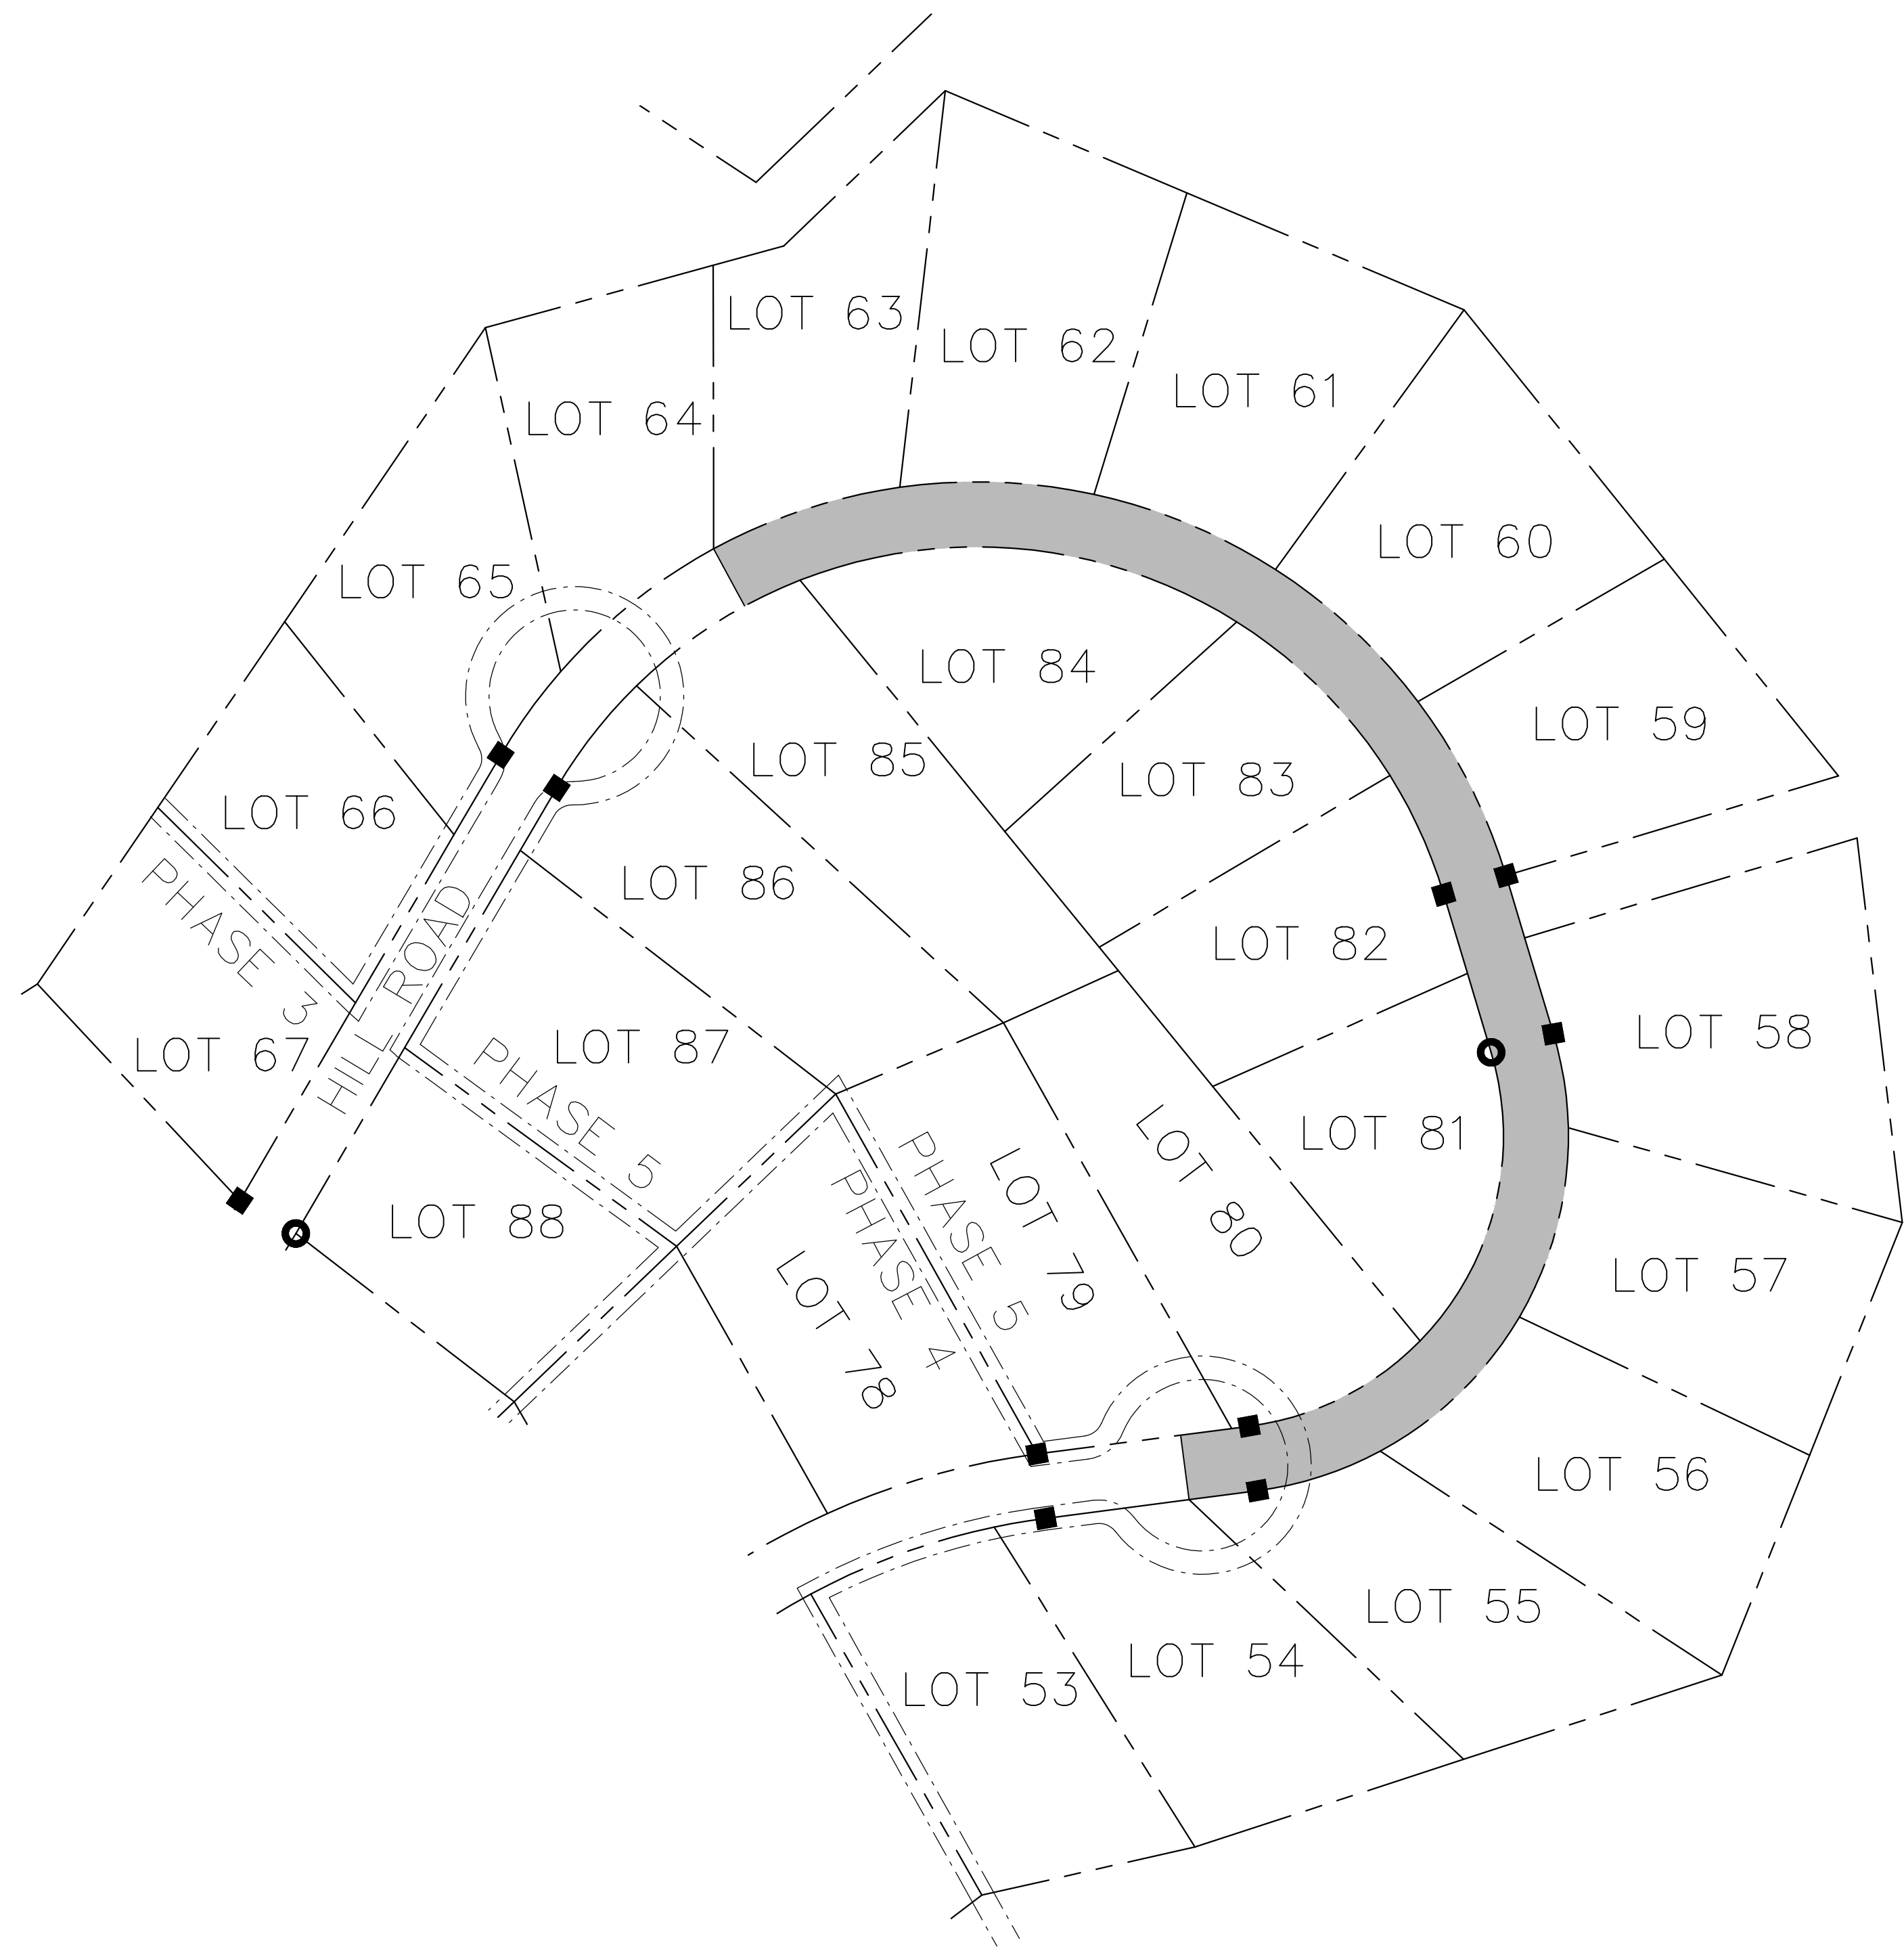

AS-BUILT MONUMENTATION

- CAPPED PIN SET
- GRANITE MONUMENT SET
- ✕ MAG NAIL SET IN DRIVEWAY

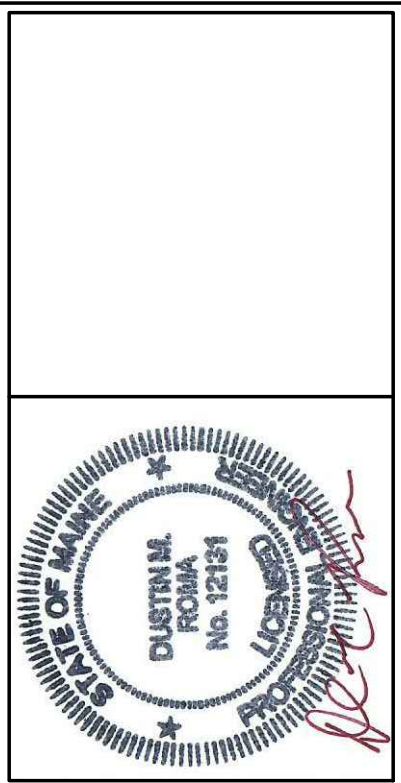

**DM ROMA**  
CONSULTING ENGINEERS  
59 HARVEST HILL RD  
WINDHAM, ME 04062  
(207) 310 - 0506

| REV | DATE | BY | DESCRIPTION |
|-----|------|----|-------------|
|     |      |    |             |
|     |      |    |             |
**AS-BUILT PLAN**  
SEBAGO HEIGHTS SUBDIVISION - PHASE 4  
WINDHAM, MAINE  
FOR RECORD OWNER:  
SEBAGO HEIGHTS, LLC  
397A EXCHANGE STREET  
PORTLAND, ME 04101

15012  
JOB NUMBER:  
1" = 100'  
SCALE:  
11-20-2017  
DATE:  
SHEET 4 OF 4  
AB-4