


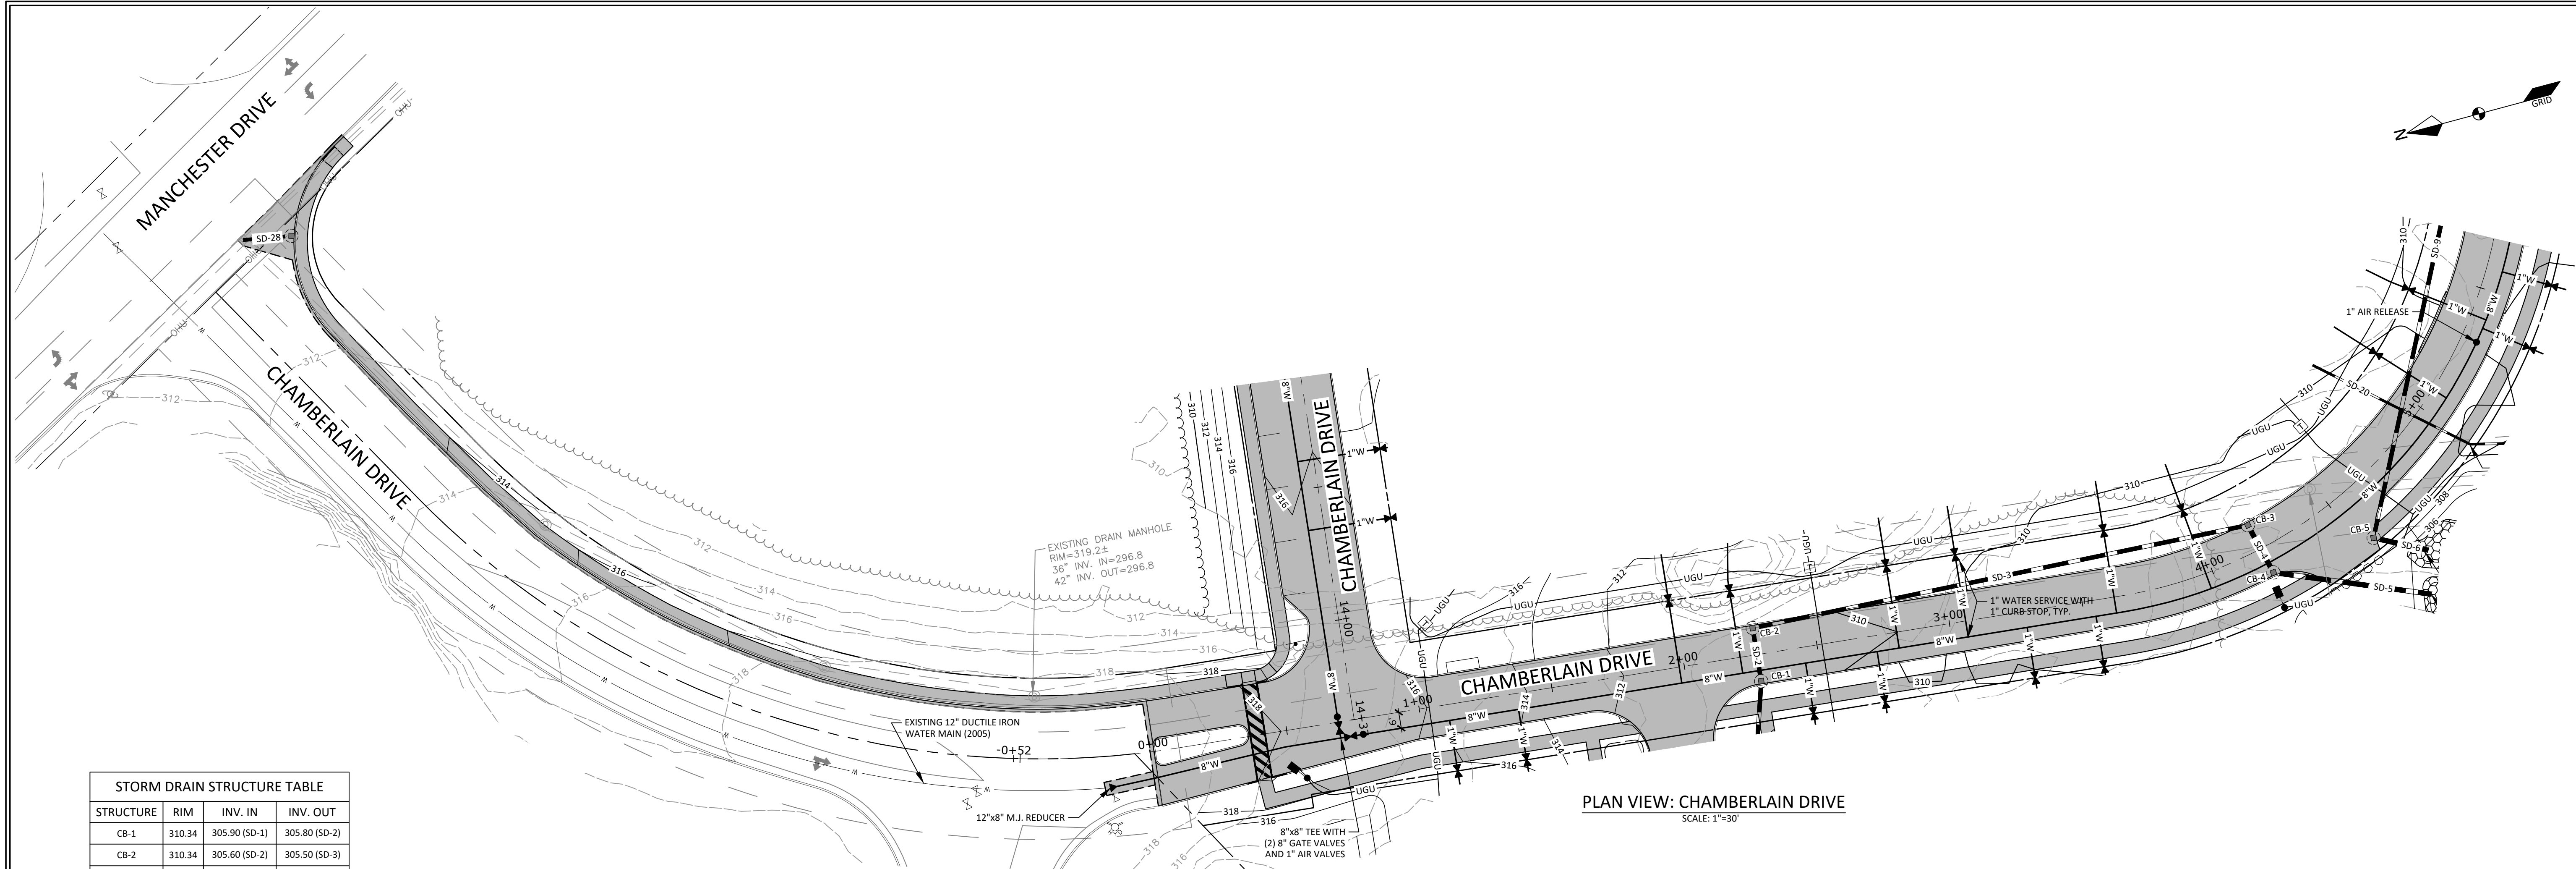

PLAN VIEW: CHAMBERLAIN DRIVE

SCALE: 1"=30'

STORM DRAIN STRUCTURE TABLE


STRUCTURE	RIM	INV. IN	INV. OUT
CB-1	310.34	305.90 (SD-1)	305.80 (SD-2)
CB-2	310.34	305.60 (SD-2)	305.50 (SD-3)
CB-3	308.55	304.60 (SD-3)	304.50 (SD-4)
CB-4	308.55	304.35 (SD-4)	304.25 (SD-5)
CB-5	308.75	304.00 (SD-9)	303.90 (SD-6)
CB-6	308.87	305.00 (SD-8)	304.90 (SD-9)
CB-7	308.87		305.10 (SD-10)
CB-8	311.20	307.20 (SD-12)	307.10 (SD-11)
CB-9	312.01	308.05 (SD-13)	307.95 (SD-12)
CB-10	312.01	308.05 (SD-14)	
CB-11	312.88	308.60 (SD-17)	308.50 (SD-14)
CB-12	312.22	308.95 (SD-16)	308.85 (SD-15)
CB-13	312.22		309.05 (SD-16)
CB-14	314.88	310.45 (SD-18)	310.35 (SD-17)
CB-15	314.88		310.60 (SD-18)
CB-16	310.50		306.50 (SD-28)
FI-1	309.35		306.35 (SD-7)
FI-2	308.70	305.70 (SD-7)	305.70 (SD-8)
OCS-1	304.80	300.33 (UD-1)	300.23 (SD-29)

STORM DRAIN PIPE TABLE

NAME	SIZE	LENGTH	SLOPE
SD-1	15"	96'	2.88%
SD-2	15"	20'	1.25%
SD-3	15"	188'	0.49%
SD-4	18"	20'	0.94%
SD-5	18"	59'	0.78%
SD-6	18"	21'	0.53%
SD-7	12"	120'	0.55%
SD-8	12"	137'	0.52%
SD-9	15"	174'	0.53%
SD-10	15"	20'	0.62%
SD-11	15"	123'	0.49%
SD-12	15"	155'	0.50%
SD-13	15"	20'	1.25%
SD-14	15"	96'	0.49%
SD-15	15"	46'	0.59%
SD-16	15"	20'	0.62%
SD-17	15"	192'	0.93%

STORM DRAIN PIPE TABLE

NAME	SIZE	LENGTH	SLOPE
SD-18	15"	20'	0.94%
SD-19	8"	128'	1.03%
SD-20	8"	94'	1.00%
SD-21	8"	234'	1.00%
SD-22	6"	69'	0.94%
SD-23	8"	168'	1.00%
SD-24	8"	87'	1.00%
SD-25	8"	111'	1.00%
SD-26	6"	60'	0.99%
SD-27	6"	46'	0.98%
SD-28	12"	18'	1.25%
SD-29	12"	26'	0.40%
SD-30	15"	124'	0.45%
SD-32	30"	68'	0.51%
SD-33	30"	126'	0.52%
UD-1	4"	11'	0.00%

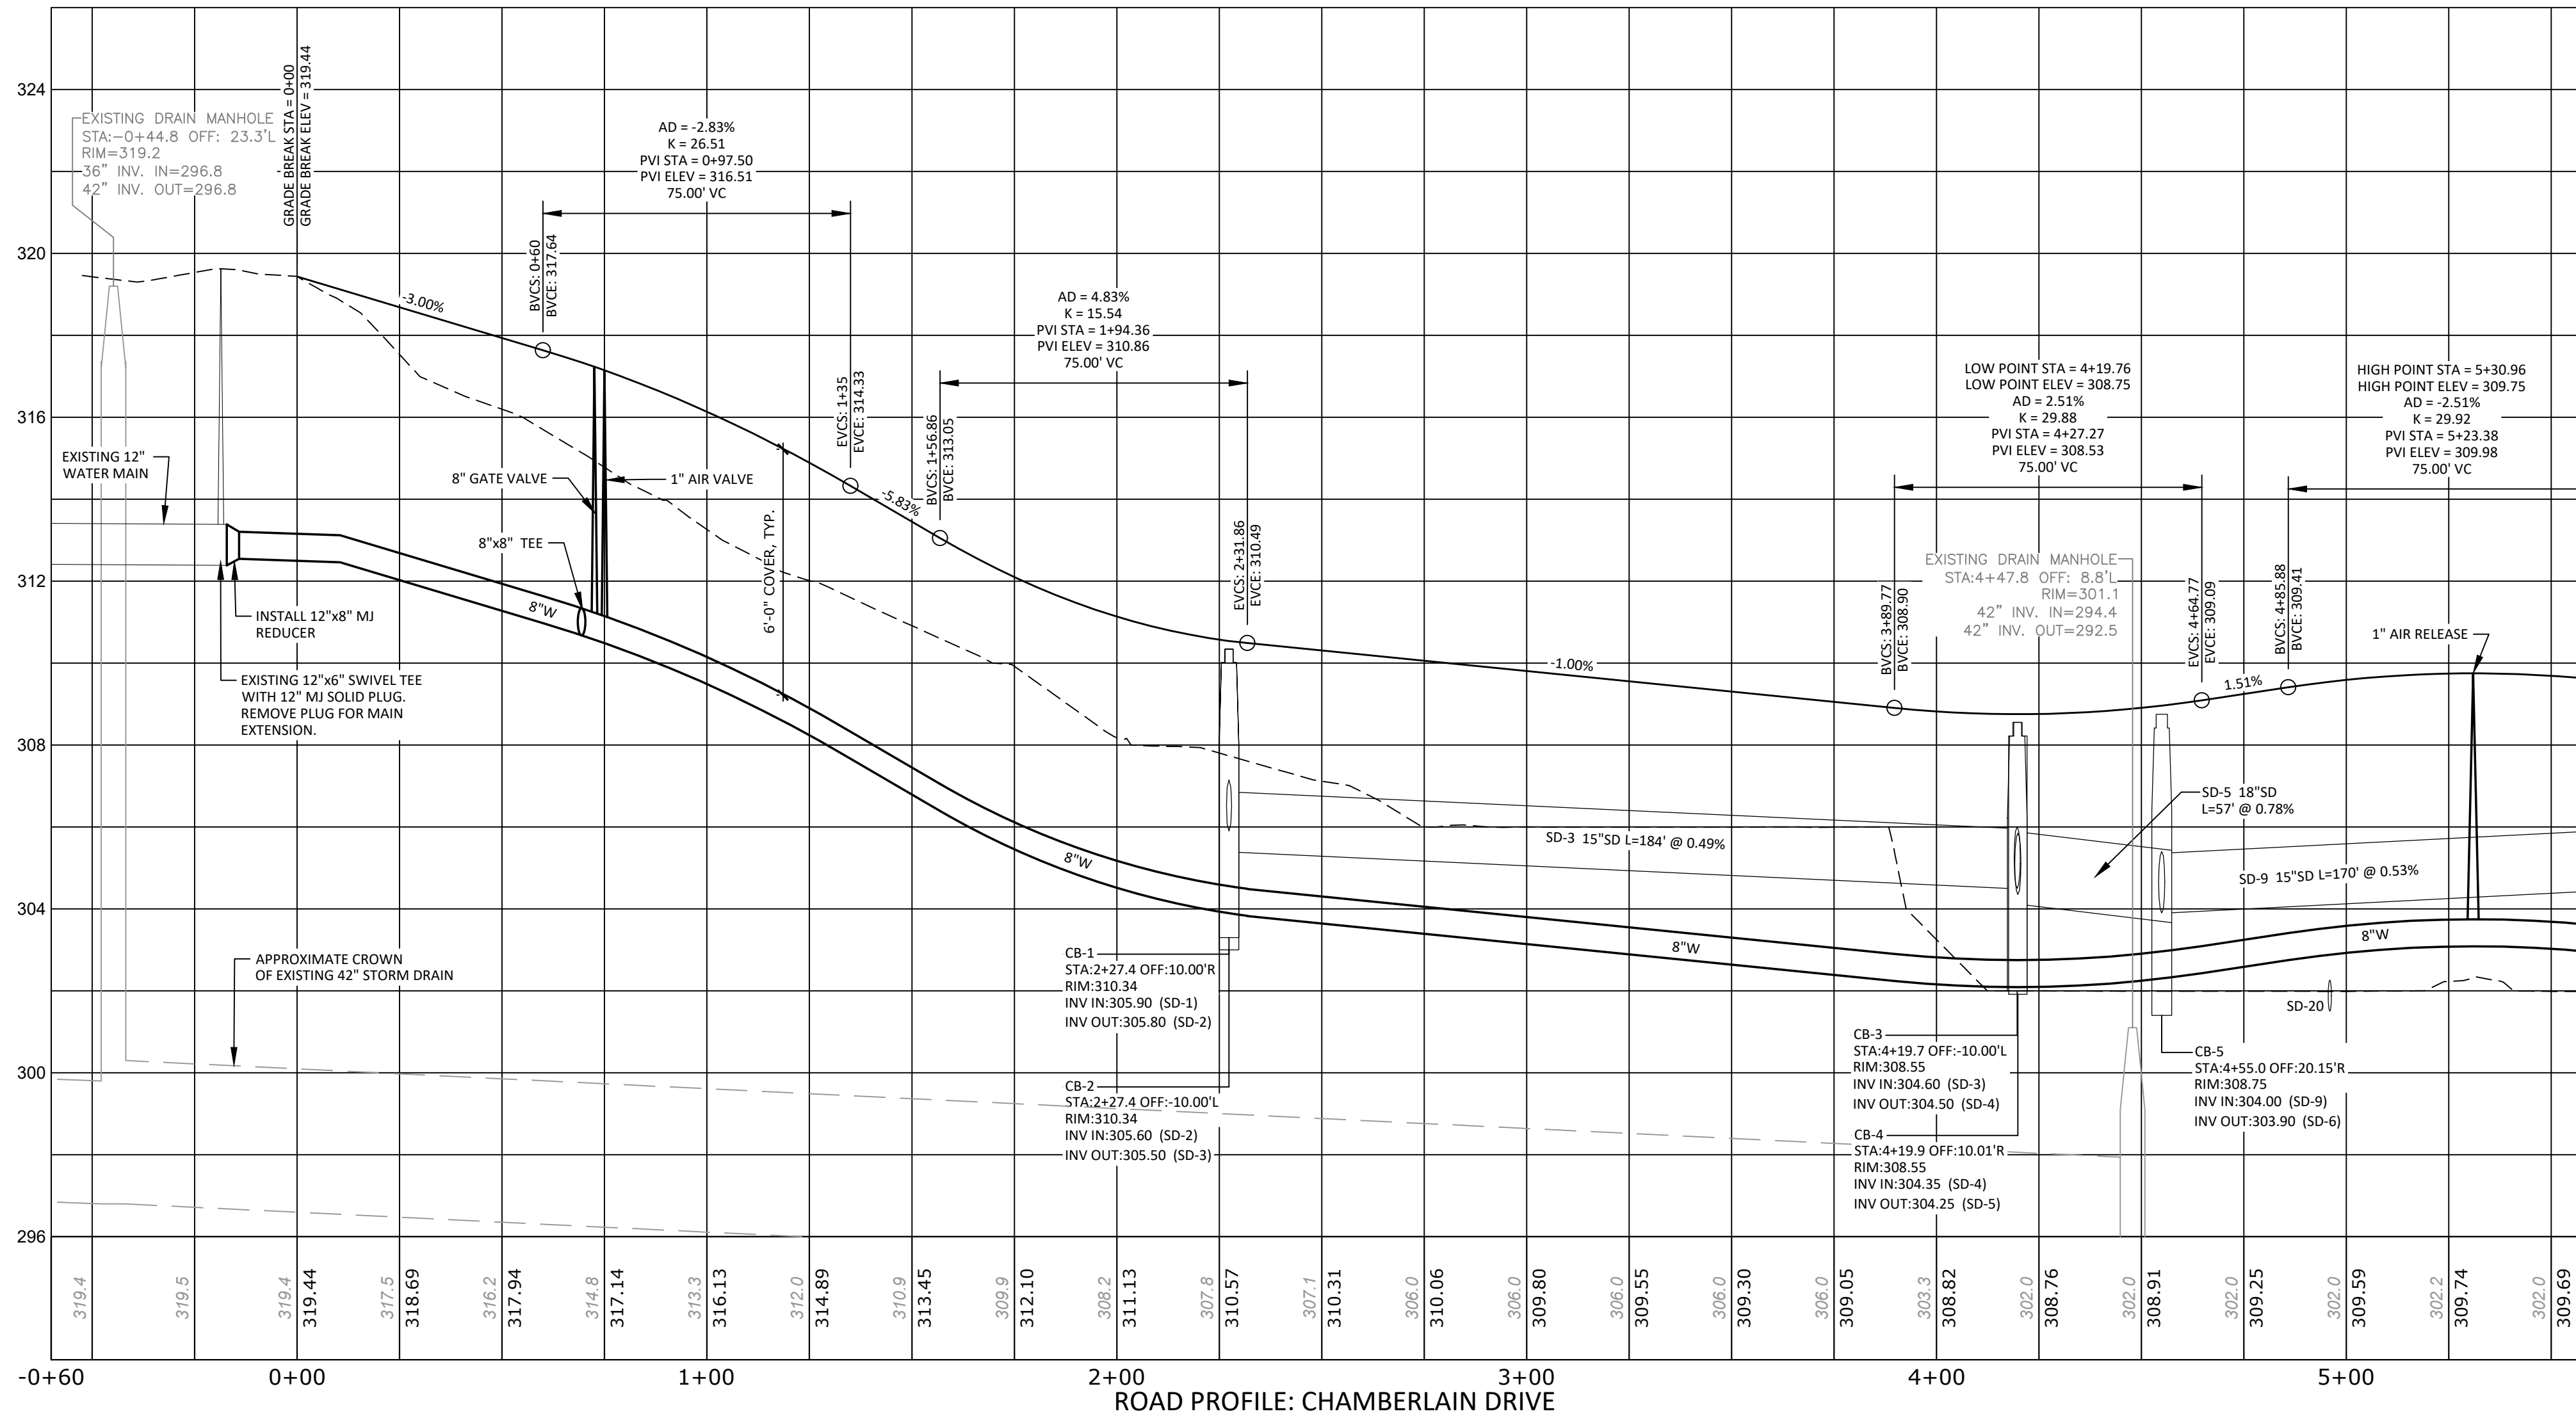

ROAD PROFILE: CHAMBERLAIN DRIVE

SCALE: HORIZ: 1"=30'
VERT: 1"=3'



LEGEND

EXISTING PROPOSED

---	PROPERTY LINE/R.O.W.	---	PROPERTY LINE/R.O.W.
---	ABUTTER PROPERTY LINE	---	ABUTTER PROPERTY LINE
---	EASEMENT LINE	---	EASEMENT LINE
---	CENTERLINE	---	CENTERLINE
---	BUILDING	---	BUILDING
---	EDGE OF PAVEMENT/CURB	---	EDGE OF PAVEMENT/CURB
---	EDGE OF GRAVEL	---	EDGE OF GRAVEL
---	SIGN	---	SIGN
---	CONTOUR LINE	---	CONTOUR LINE
---	TREELINE	---	TREELINE
TP	TEST PIT	TP	TEST PIT
CB	CATCHBASIN	CB	CATCHBASIN
DM	DRAINAGE MANHOLE	DM	DRAINAGE MANHOLE
UD	CULVERT/STORMDRAIN UNDERDRAIN	UD	CULVERT/STORMDRAIN UNDERDRAIN
S	SANITARY SEWER PIPE	S	SANITARY SEWER PIPE
W	WATER MAIN	W	WATER MAIN
WV	WATER VALVE	WV	WATER VALVE
HY	HYDRANT	HY	HYDRANT
AR	AIR RELEASE	AR	AIR RELEASE
UP	UTILITY POLE	UP	UTILITY POLE
OHU	OVERHEAD UTILITIES	OHU	OVERHEAD UTILITIES
UGU	UNDERGROUND UTILITIES	UGU	UNDERGROUND UTILITIES
TP	TRANSFORMER PAD	TP	TRANSFORMER PAD
RP	RIPRAP	RP	RIPRAP
SF	SILT FENCE	SF	SILT FENCE

AS-BUILT NOTES:

1. BASE PLAN INFORMATION FROM PLANS PREPARED BY DM ROMA CONSULTING ENGINEERS.
2. AS-BUILT INFORMATION IS BASED ON CONSTRUCTION NOTES PROVIDED BY SITE CONTRACTOR. ANY DEVIATIONS FROM DESIGN PLANS AS NOTED BY SITE CONTRACTOR ARE SHOWN IN RED.

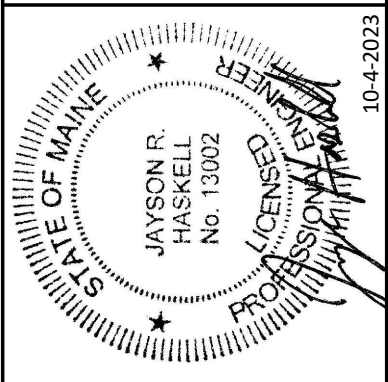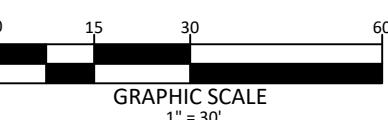

DM ROMA
CONSULTING ENGINEERS
P.O. BOX 1116
WINDHAM, ME 04062
(207) 310-0506

REV	DATE	BY	DESCRIPTION
A	10-4-23	JRH	AS-BUILT PLANS

AS-BUILT: CHAMBERLAIN DRIVE
CHAMBERLAIN ESTATES
CHAMBERLAIN DRIVE
WINDHAM, MAINE
FOR: **ROBIE HOLDINGS, LLC**
P.O. BOX 1508
WINDHAM, ME 04062

20039
JOB NUMBER:
AS NOTED
SCALE:
10-4-2023
DATE:
SHEET 1 OF 4
PP-1