
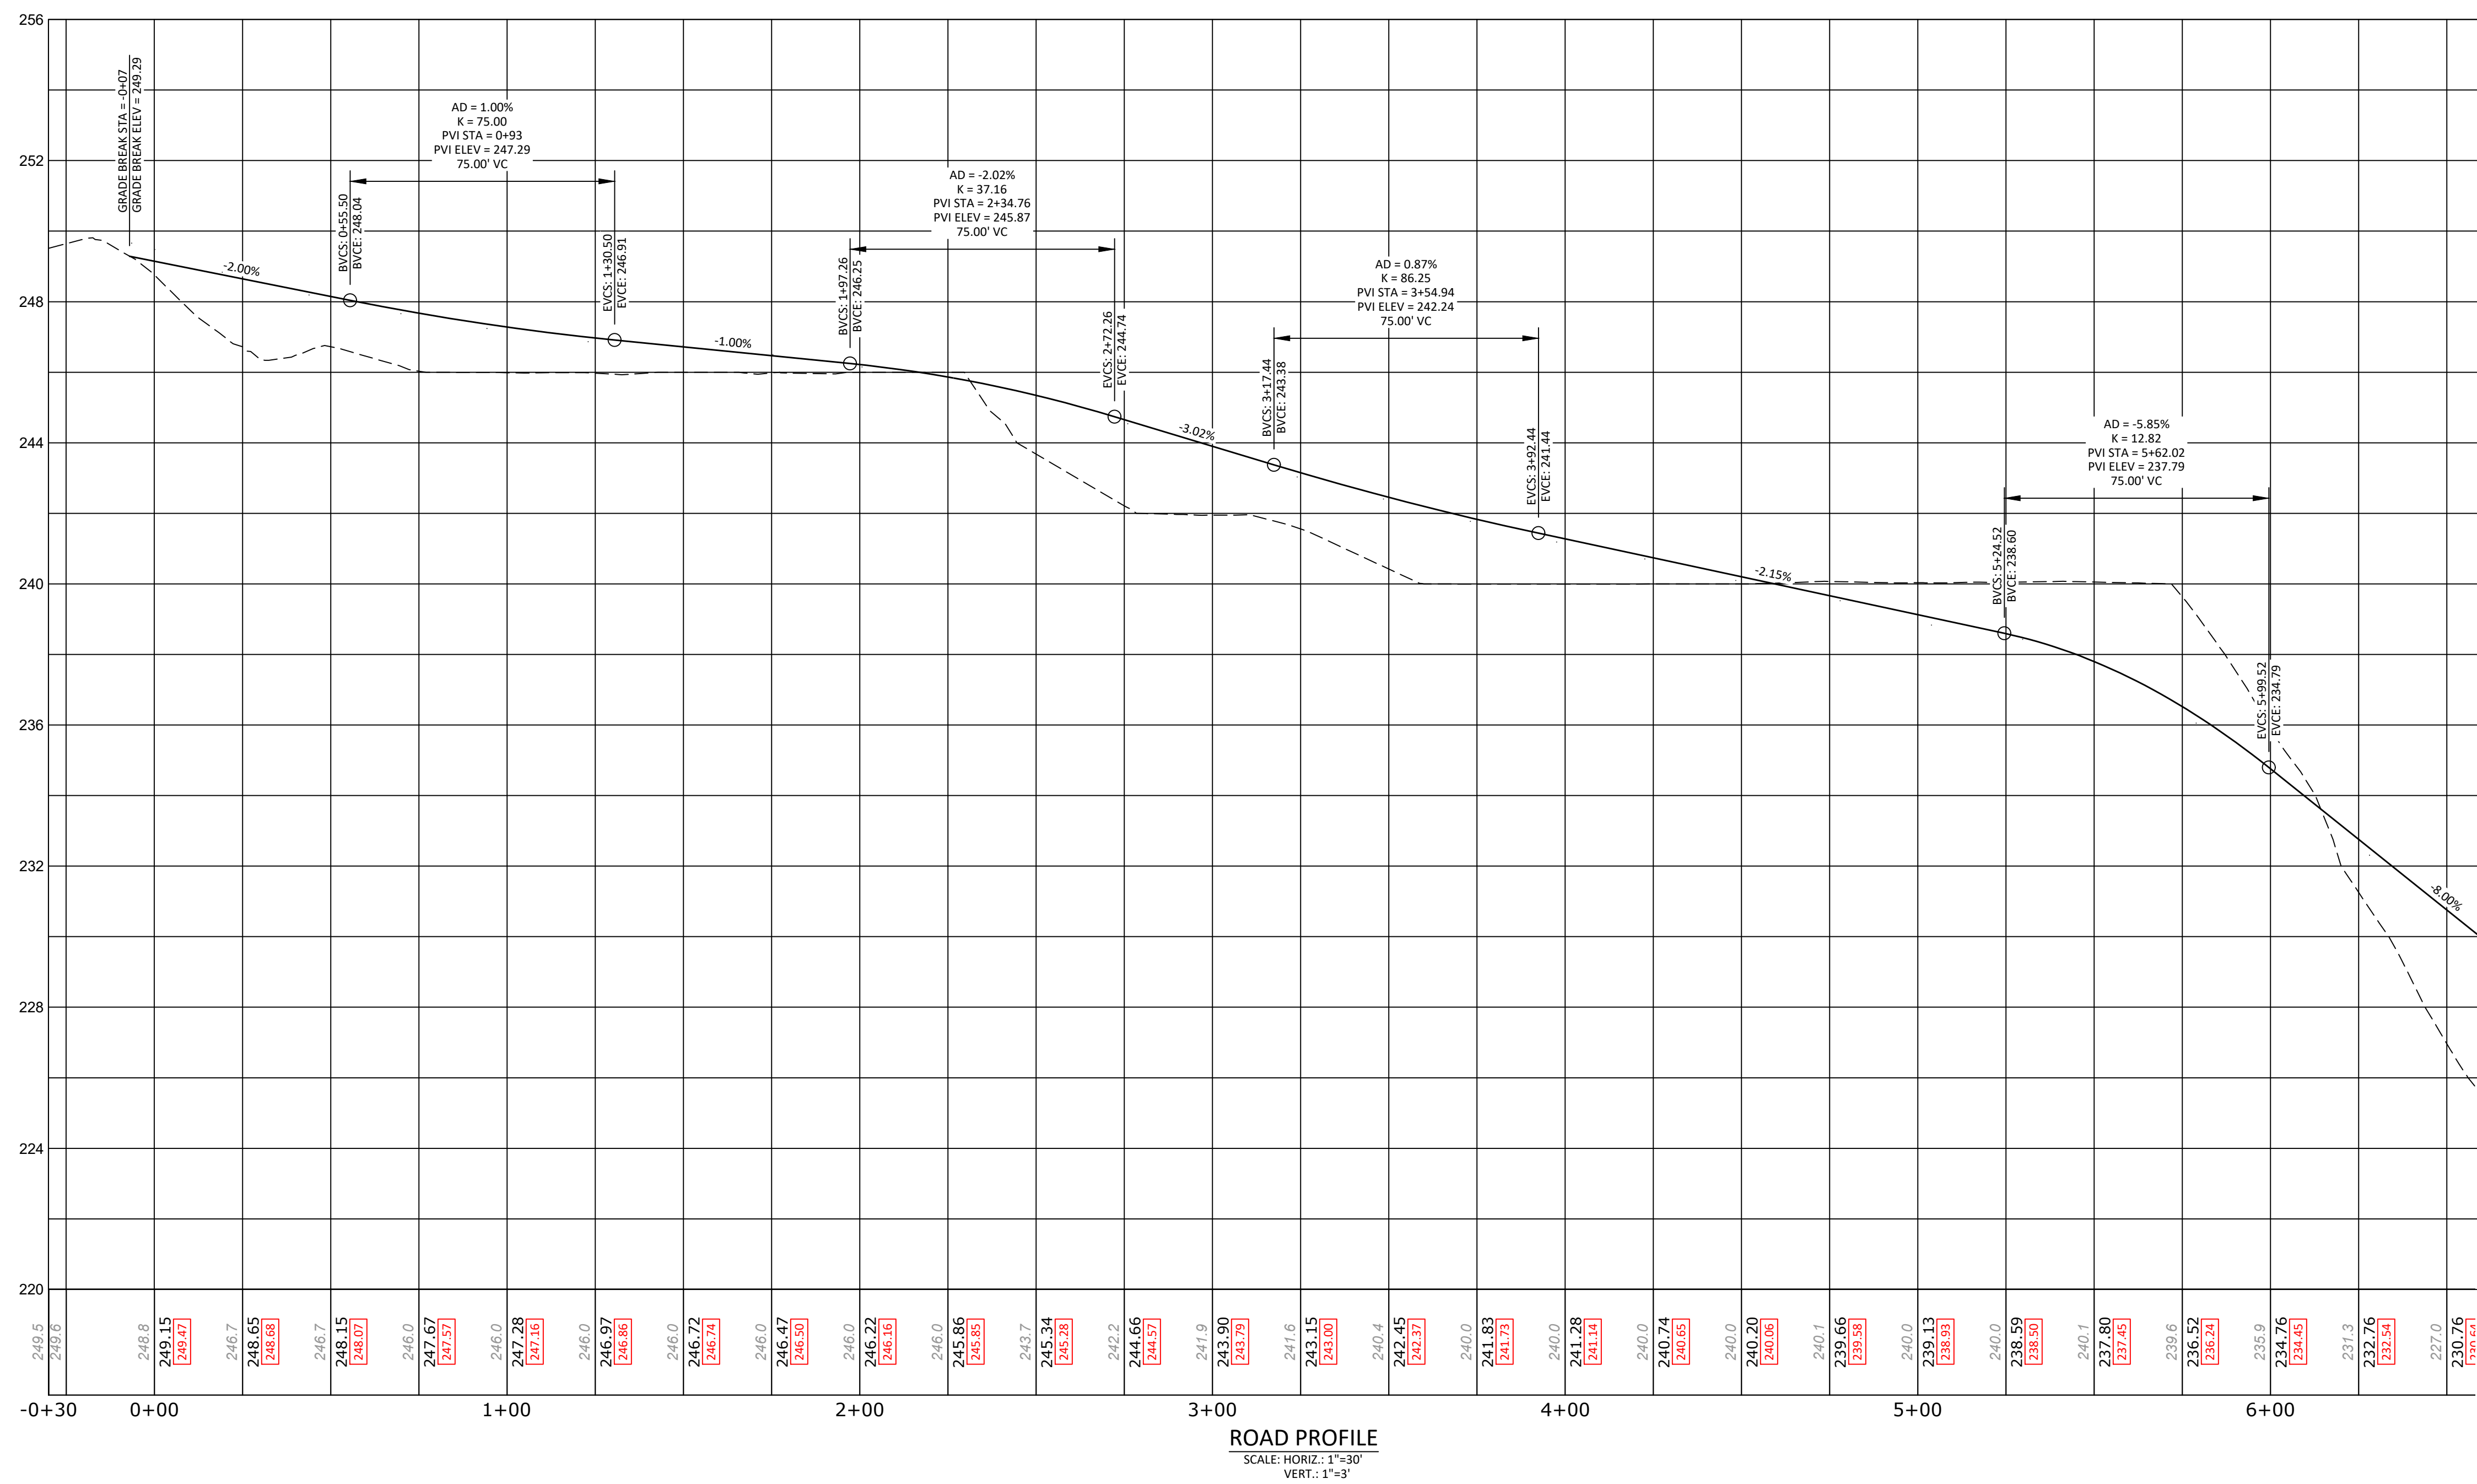


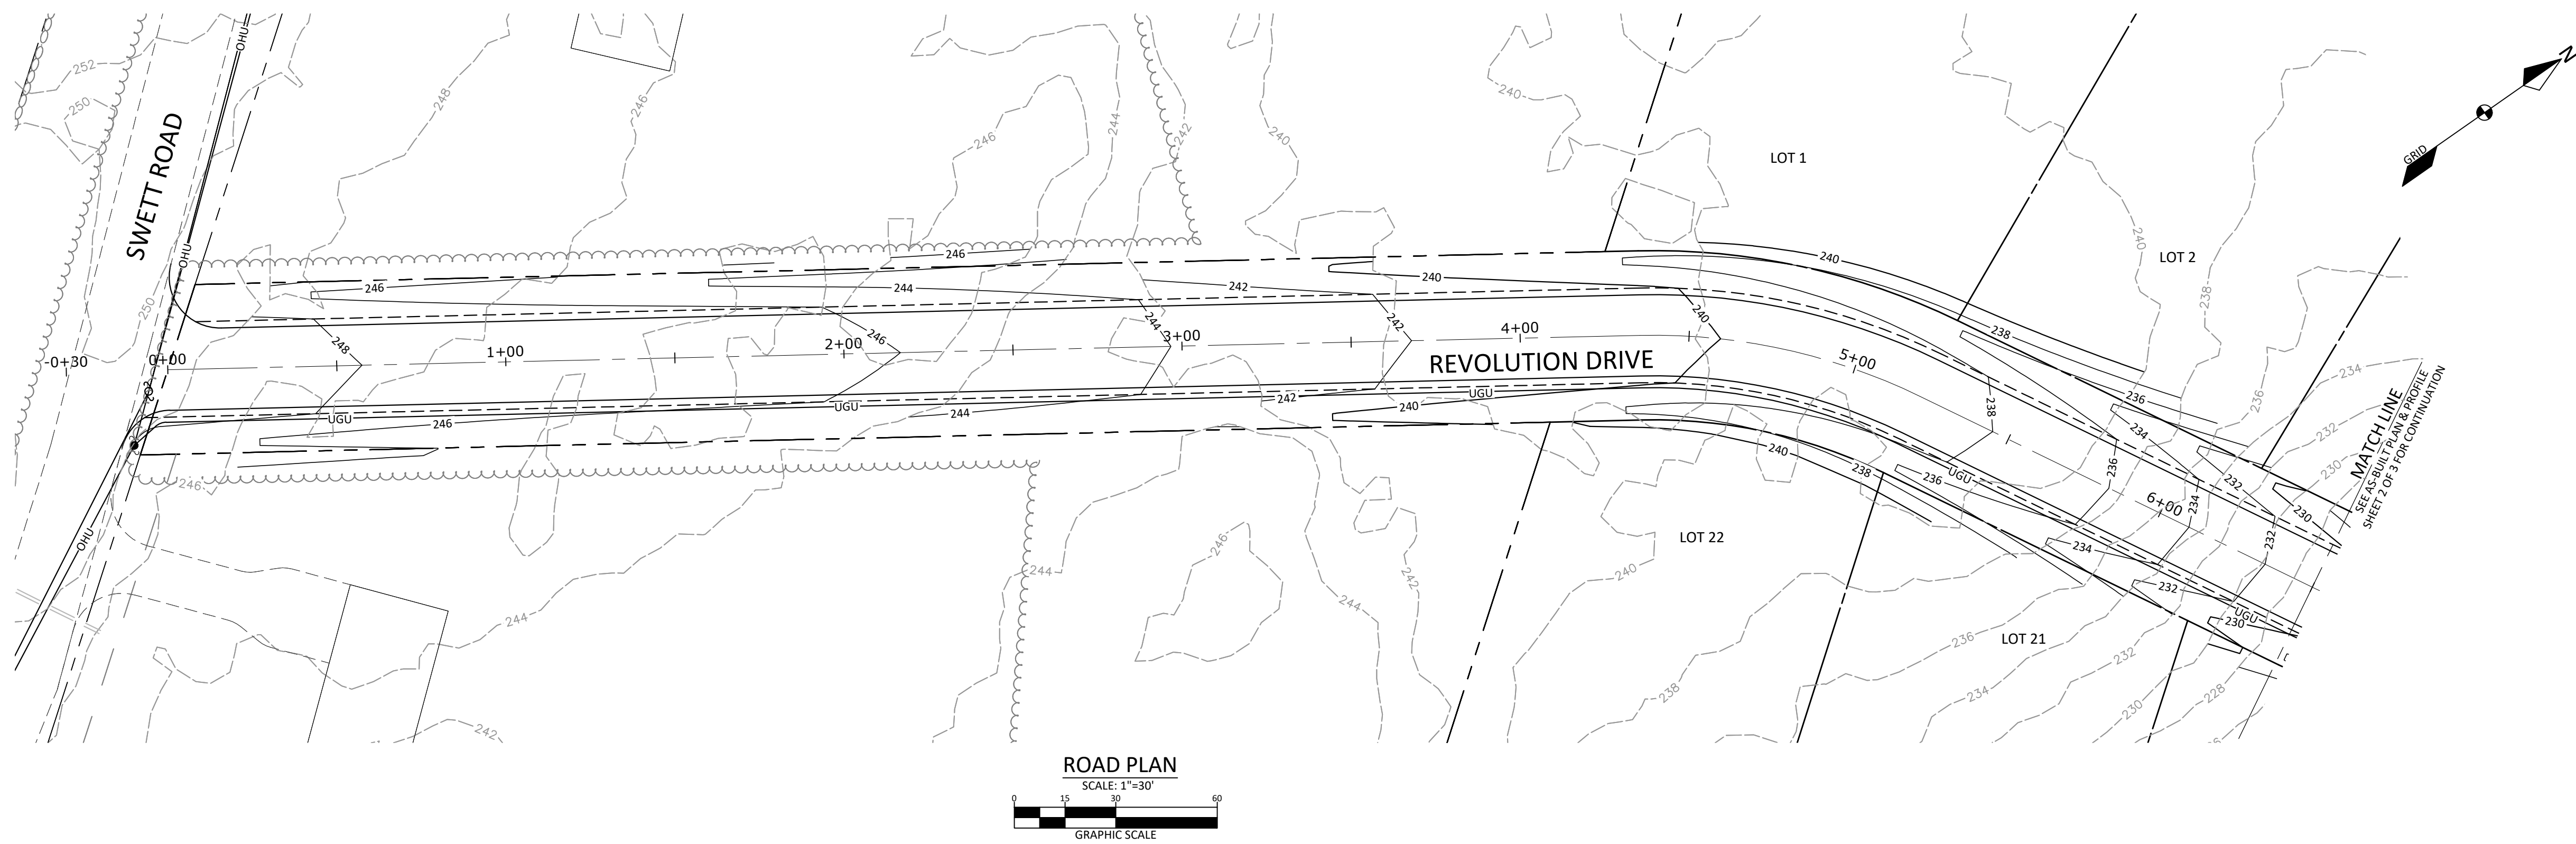

AS-BUILT NOTES:

1. BASE PLAN INFORMATION FROM PLANS PREPARED BY DM ROMA CONSULTING ENGINEERS.
2. AS-BUILT INFORMATION IS BASED ON ONE SITE VISIT BY DM ROMA CONSULTING ENGINEERS UTILIZING GPS EQUIPMENT TO LOCATE SITE IMPROVEMENTS. OBSERVED DEVIATIONS FROM DESIGN PLANS ARE SHOWN IN RED.


EXISTING		PROPOSED	
---	PROPERTY LINE/R.O.W.	---	---
---	ABUTTER PROPERTY LINE	---	---
---	SETBACK	---	---
---	EASEMENT LINE	---	---
	GRANITE MONUMENT		---
	IRON PIN/DRILL HOLE		---
---	CENTERLINE	---	---
	BUILDING	---	---
---	EDGE OF PAVEMENT/CURB	---	---
---	EDGE OF GRAVEL	---	---
	EDGE OF WETLANDS	---	---
---200'---201'---	CONTOUR LINE	---200'---201'---	---
---	TREELINE	---	---
	CATCHBASIN		---
	DRAINAGE MANHOLE		---
---	CULVERT/STORMDRAIN	---	---
---	UNDERDRAIN	---	UD
	UTILITY POLE		---
OHU	OVERHEAD UTILITIES	OHU	---
UGU	UNDERGROUND UTILITIES	UGU	---
---	TRANSFORMER PAD		---
	RIPRAP		---
---	SILT FENCE	---	---

DM ROMA
CONSULTING ENGINEERS
P.O. BOX 1116
WINDHAM, ME 04062
(207) 310 - 0506

REV	DATE	BY	DESCRIPTION
A	6-20-25	DMR	AS-BUILT CONDITIONS

AS-BUILT PLAN & PROFILE: STA. 0+30 THRU STA. 6+50
 MAJESTIC WOODS SUBDIVISION
 WINDHAM, MAINE
 FOR RECORD OWNER:
 SHORELAND DEVELOPMENT, LLC
 2320 CONGRESS STREET
 PORTLAND, MAINE 04102

17002 JOB NUMBER:
AS NOTED SCALE:
6-20-2025 DATE:
SHEET 1 OF 3
APP-1

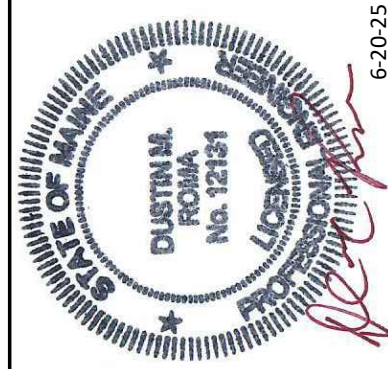

DM ROMA
CONSULTING ENGINEERS
P.O. BOX 11116
WINDHAM, ME 04062
(207) 310 - 0506

[illegible]

AS-BUILT PLAN & PROFILE: **REVOLUTION DRIVE**
STA. 6+50 THRU STA. 13+00

MAJESTIC WOODS SUBDIVISION
WINDHAM, MAINE

FOR RECORD OWNER:
SHORELAND DEVELOPMENT, LLC
2320 CONGRESS STREET


17002
JOB NUMBER:


AS NOTED


6-20-2025

SHEET 2 OF 3


APP-2

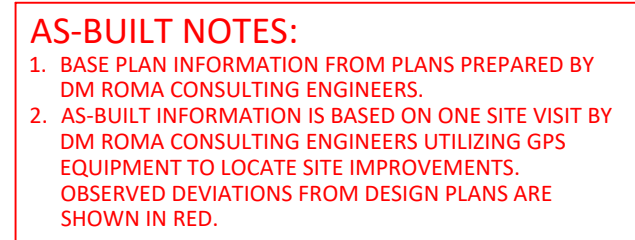

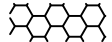LEGEND			
EXISTING			PROPOSED
---	PROPERTY LINE/R.O.W.	---	---
---	ABUTTER PROPERTY LINE	---	---
---	SETBACK	---	---
---	EASEMENT LINE	---	---
	GRANITE MONUMENT		
	IRON PIN/DRILL HOLE		
---	CENTERLINE	---	---
---	BUILDING	---	---
---	EDGE OF PAVEMENT/CURB	---	---
---	EDGE OF GRAVEL	---	---
---	EDGE OF WETLANDS	---	---
---200'---201'---	CONTOUR LINE	---200'---201'---	---
	TREELINE		
	CATCHBASIN		
	DRAINAGE MANHOLE		
==	CULVERT/STORMDRAIN		
---	UNDERDRAIN	---	UD
	UTILITY POLE		
OHU	OVERHEAD UTILITIES	OHU	
UGU	UNDERGROUND UTILITIES	UGU	
---	TRANSFER PAD		
	RIPRAP		
---	SILT FENCE	---	---

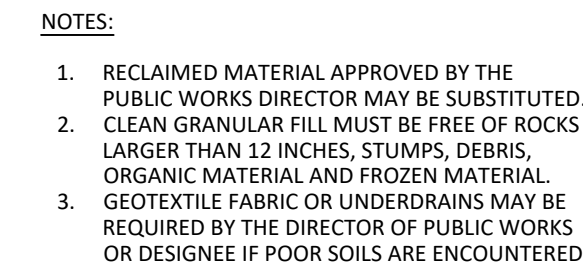



TYPICAL ROADWAY SECTION
NOT TO SCALE

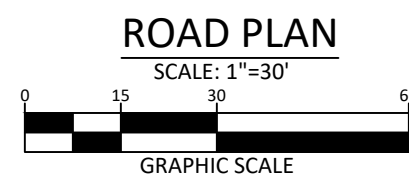

AS-BUILT NOTES:

1. BASE PLAN INFORMATION FROM PLANS PREPARED BY DM ROMA CONSULTING ENGINEERS.
2. AS-BUILT INFORMATION IS BASED ON ONE SITE VISIT BY DM ROMA CONSULTING ENGINEERS UTILIZING GPS EQUIPMENT TO LOCATE SITE IMPROVEMENTS. OBSERVED DEVIATIONS FROM DESIGN PLANS ARE SHOWN IN RED.

EXISTING		PROPOSED	
---	PROPERTY LINE/R.O.W.	---	---
---	ABUTTER PROPERTY LINE	---	---
---	SETBACK	---	---
---	EASEMENT LINE	---	---
	GRANITE MONUMENT		---
	IRON PIN/DRILL HOLE		---
---	CENTERLINE	---	---
---	BUILDING	---	---
---	EDGE OF PAVEMENT/CURB	---	---
---	EDGE OF GRAVEL	---	---
	EDGE OF WETLANDS	---	---
---200'---	CONTOUR LINE	---	---
---	TREELINE	---	---
	CATCHBASIN		---
	DRAINAGE MANHOLE		---
---	CULVERT/STORMDRAIN	---	---
---	UNDERDRAIN	---	---
	UTILITY POLE		UD
OHU	OVERHEAD UTILITIES	OHU	---
UGU	UNDERGROUND UTILITIES	UGU	---
---	TRANSFER PAD		---
	RIPRAP		---
---	SILT FENCE	---	---

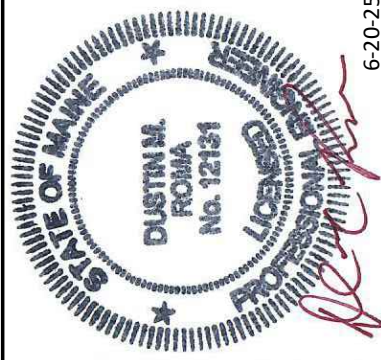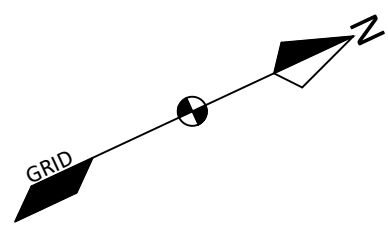

DM ROMA
CONSULTING ENGINEERS
P.O. BOX 1116
WINDHAM, ME 04062
(207) 310 - 0506

REV	DATE	BY	DESCRIPTION
A.	6-20-25	DMR	AS-BUILT CONDITIONS

AS-BUILT PLAN & PROFILE: **REVOLUTION DRIVE**
STA. 13+00 THRU STA. 19+31
 MAJESTIC WOODS SUBDIVISION
 WINDHAM, MAINE
 FOR RECORD OWNER:
 SHORELAND DEVELOPMENT, LLC
 2320 CONGRESS STREET

17002
JOB NUMBER:
S NOTED
SCALE:
-20-2025
DATE:
EET 3 OF 3
APP-3