


SEBAGO HEIGHTS SUBDIVISION PHASE 5 AS-BUILT PLANS

HARVEST HILL ROAD
WINDHAM, MAINE
NOVEMBER 20, 2017





AS-BUILT DRAWING SHEET INDEX	
PAGE NO.	DESCRIPTION
1	TITLE SHEET
2	AS-BUILT PLAN HARVEST HILL ROAD
3	AS-BUILT PLAN HARVEST HILL ROAD
4	AS-BUILT PLAN MONUMENTATION

INDEX MAP

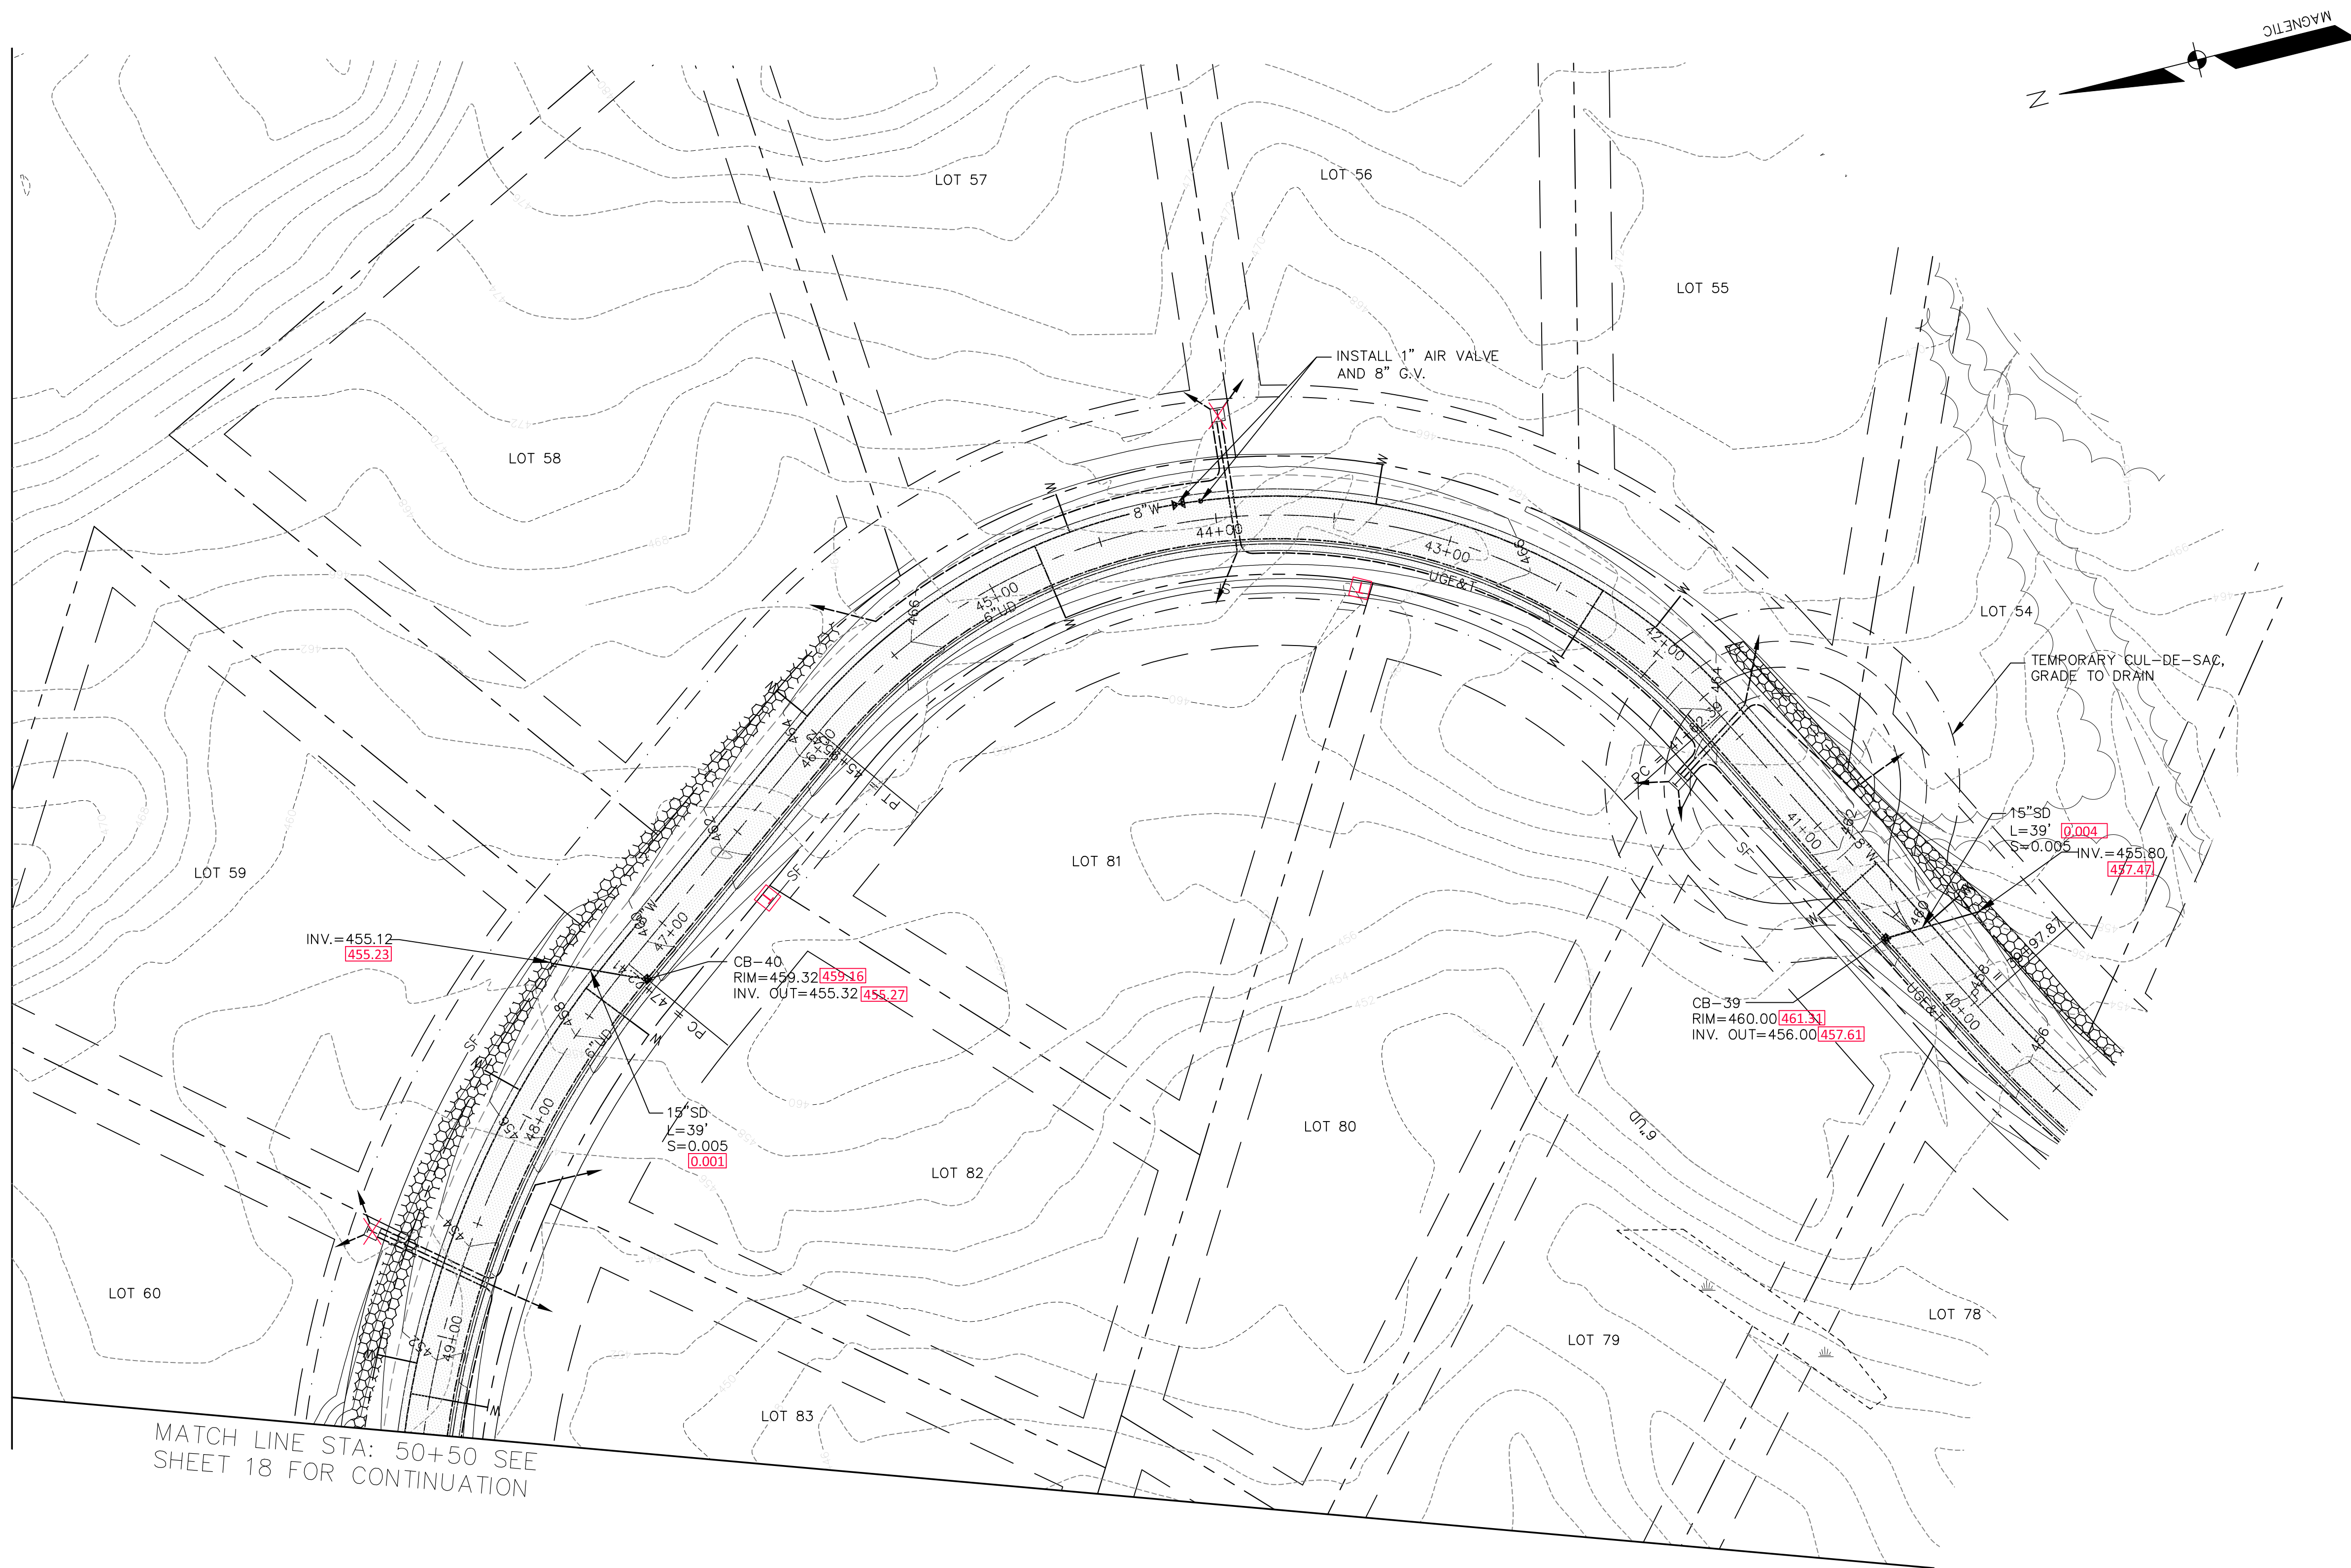

AS-BUILT PLAN NOTES:

1. BASE PLAN INFORMATION FROM PLANS PREPARED BY SEBAGO TECHNIQS, INC.
2. AS-BUILT INFORMATION SHOWN HEREON BASED SOLELY ON CONTRACTOR'S NOTES PROVIDED BY R.J. GRONDIN & SONS.

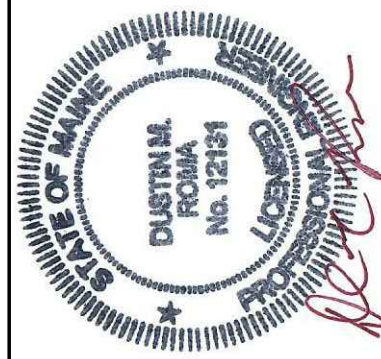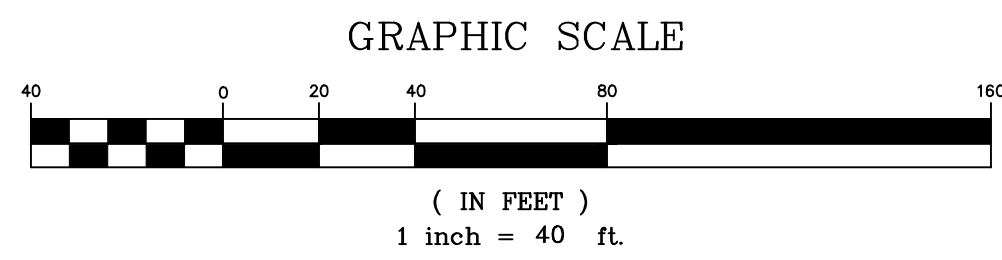


DM ROMA
CONSULTING ENGINEERS
59 HARVEST HILL RD
WINDHAM, ME 04062
(207) 310-0506

REV	DATE	BY	DESCRIPTION


AS-BUILT PLAN
SEBAGO HEIGHTS SUBDIVISION - PHASE 5
WINDHAM, MAINE
FOR RECORD OWNER:
SEBAGO HEIGHTS, LLC
97A EXCHANGE STREET
PORTLAND, ME 04101

15012 JOB NUMBER:
1" = 40' SCALE:
11-20-2017 DATE:
SHEET 2 OF 4
AB-2

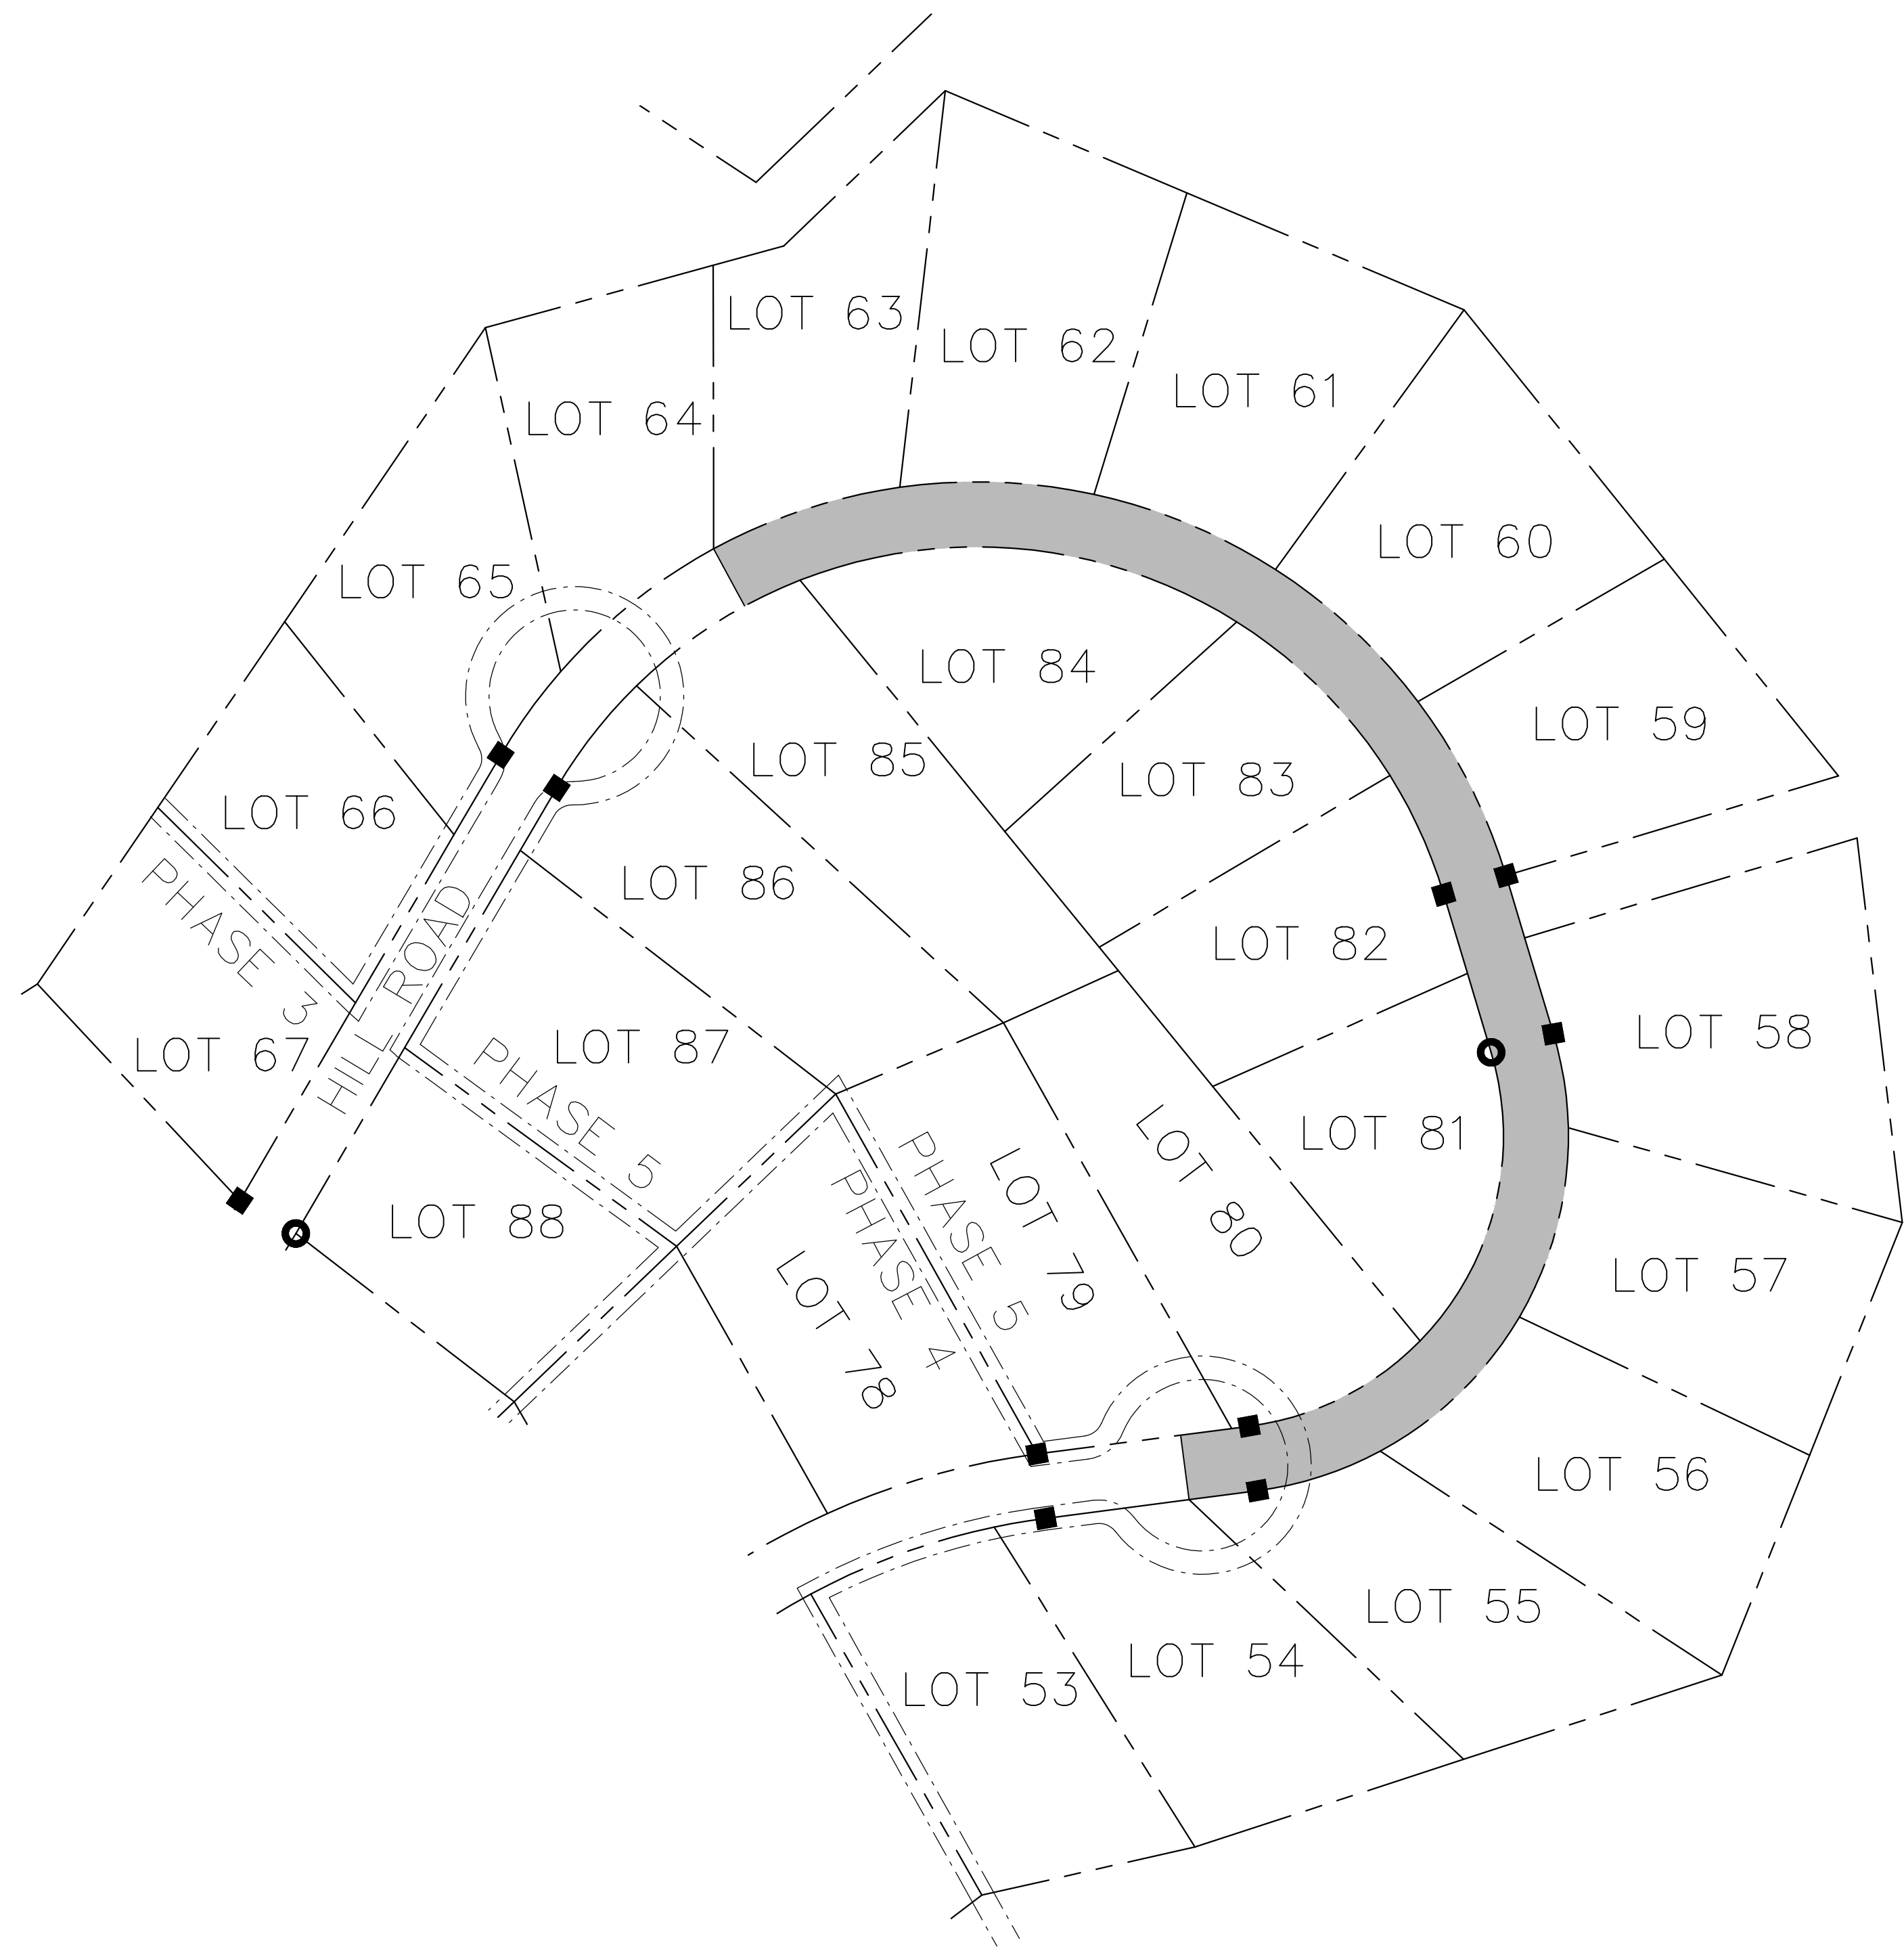

AS-BUILT MONUMENTATION

- CAPPED PIN SET
- GRANITE MONUMENT SET
- ✕ MAG NAIL SET IN DRIVEWAY

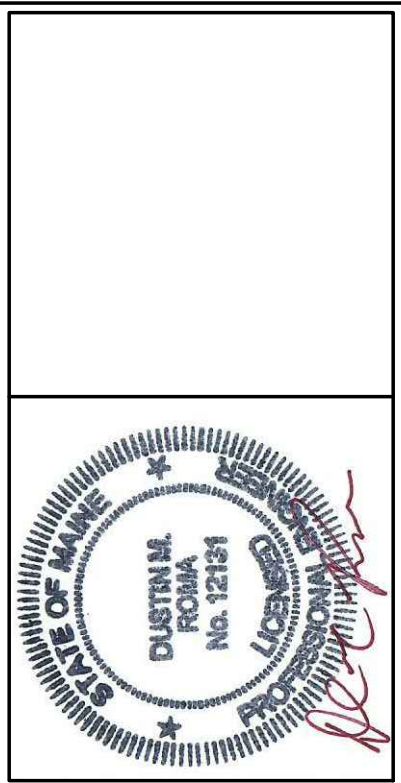

DM ROMA
CONSULTING ENGINEERS
59 HARVEST HILL RD
WINDHAM, ME 04062
(207) 310 - 0506

REV	DATE	BY	DESCRIPTION

AS-BUILT PLAN
SEBAGO HEIGHTS SUBDIVISION - PHASE 4
WINDHAM, MAINE
FOR RECORD OWNER:
SEBAGO HEIGHTS, LLC
37A EXCHANGE STREET
PORTLAND, ME 04101

15012
JOB NUMBER:
1" = 100'
SCALE:
11-20-2017
DATE:
SHEET 4 OF 4
AB-4