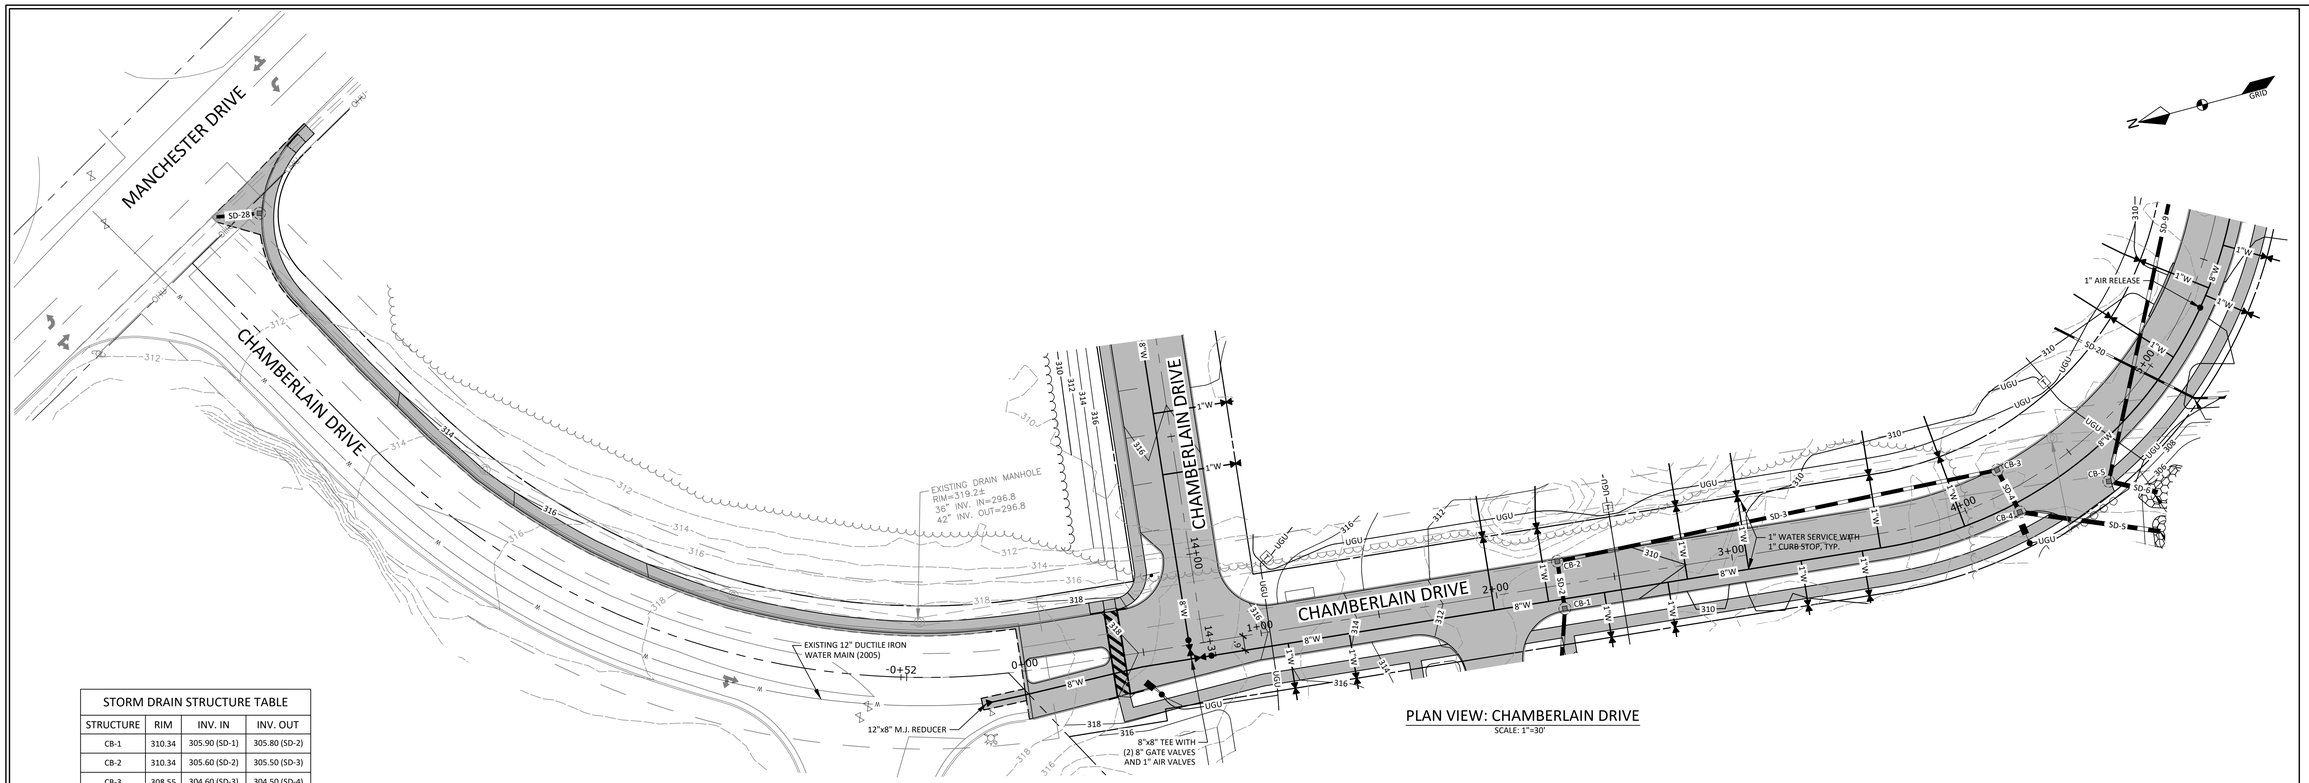

PLAN VIEW: CHAMBERLAIN DRIVE

SCALE: 1"=30'

STORM DRAIN STRUCTURE TABLE			
STRUCTURE	RIM	INV. IN	INV. OUT
CB-1	310.34	305.90 (SD-1)	305.80 (SD-2)
CB-2	310.34	305.60 (SD-2)	305.50 (SD-3)
CB-3	308.55	304.60 (SD-3)	304.50 (SD-4)
CB-4	308.55	304.35 (SD-4)	304.25 (SD-5)
CB-5	308.75	304.00 (SD-9)	303.90 (SD-6)
CB-6	308.87	305.00 (SD-8) 305.00 (SD-10)	304.90 (SD-9)
CB-7	308.87		305.10 (SD-10)
CB-8	311.20	307.20 (SD-12)	307.10 (SD-11)
CB-9	312.01	308.05 (SD-13) 308.05 (SD-14)	307.95 (SD-12)
CB-10	312.01		308.25 (SD-13)
CB-11	312.88	308.60 (SD-17) 308.60 (SD-15)	308.50 (SD-14)
CB-12	312.22	308.95 (SD-16)	308.85 (SD-15)
CB-13	312.22		309.05 (SD-16)
CB-14	314.88	310.45 (SD-18)	310.35 (SD-17)
CB-15	314.88		310.60 (SD-18)
CB-16	310.50		306.50 (SD-28)
FI-1	309.35		306.35 (SD-7)
FI-2	308.70	305.70 (SD-7)	305.70 (SD-8)
OCS-1	304.80	300.33 (UD-1)	300.23 (SD-29)

STORM DRAIN PIPE TABLE			
NAME	SIZE	LENGTH	SLOPE
SD-1	15"	96'	2.88%
SD-2	15"	20'	1.25%
SD-3	15"	188'	0.49%
SD-4	18"	20'	0.94%
SD-5	18"	59'	0.78%
SD-6	18"	21'	0.53%
SD-7	12"	120'	0.55%
SD-8	12"	137'	0.52%
SD-9	15"	174'	0.53%
SD-10	15"	20'	0.62%
SD-11	15"	123'	0.49%
SD-12	15"	155'	0.50%
SD-13	15"	20'	1.25%
SD-14	15"	96'	0.49%
SD-15	15"	46'	0.59%
SD-16	15"	20'	0.62%
SD-17	15"	192'	0.93%

STORM DRAIN PIPE TABLE			
NAME	SIZE	LENGTH	SLOPE
SD-18	15"	20'	0.94%
SD-19	8"	128'	1.03%
SD-20	8"	94'	1.00%
SD-21	8"	234'	1.00%
SD-22	6"	69'	0.94%
SD-23	8"	168'	1.00%
SD-24	8"	87'	1.00%
SD-25	8"	111'	1.00%
SD-26	6"	60'	0.99%
SD-27	6"	46'	0.98%
SD-28	12"	18'	1.25%
SD-29	12"	26'	0.40%
SD-30	15"	124'	0.45%
SD-32	30"	68'	0.51%
SD-33	30"	126'	0.52%
UD-1	4"	11'	0.00%

LEGEND

EXISTING		PROPOSED
	PROPERTY LINE/R.O.W.	
	ABUTTER PROPERTY LINE	
	EASEMENT LINE	
	CENTERLINE	
	BUILDING	
	EDGE OF PAVEMENT/CURB	
	EDGE OF GRAVEL	
	SIGN	
200 201	CONTOUR LINE	200 201
	TREELINE	
TP-1	TEST PIT	
	CATCHBASIN	
	DRAINAGE MANHOLE	
	CULVERT/STORMDRAIN	
	UNDERDRAIN	UD
S	SANITARY SEWER PIPE	S
W	WATER MAIN	W
WV	WATER VALVE	
	HYDRANT	
	AIR RELEASE	
	UTILITY POLE	
OHU	OVERHEAD UTILITIES	
UGU	UNDERGROUND UTILITIES	UGU
	TRANSFORMER PAD	T
	RIPRAP	
	SILT FENCE	SF

AS-BUILT NOTES:

1. BASE PLAN INFORMATION FROM PLANS PREPARED BY DM ROMA CONSULTING ENGINEERS.
2. AS-BUILT INFORMATION IS BASED ON CONSTRUCTION NOTES PROVIDED BY SITE CONTRACTOR. ANY DEVIATIONS FROM DESIGN PLANS AS NOTED BY SITE CONTRACTOR ARE SHOWN IN RED.

0 15 30 60

GRAPHIC SCALE
1" = 30'

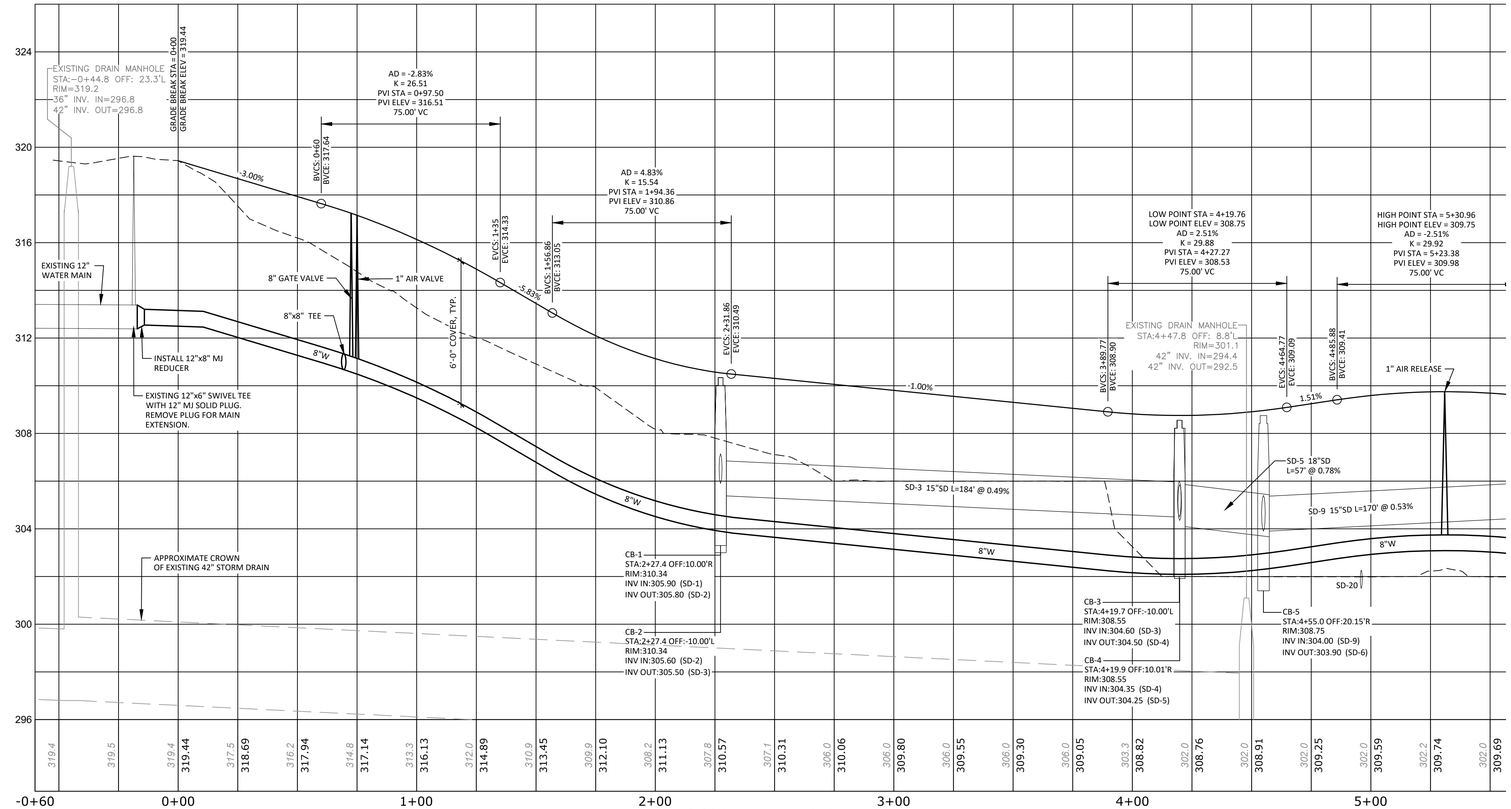

ROAD PROFILE: CHAMBERLAIN DRIVE

SCALE: HORIZ.: 1"=30'
VERT.: 1"=3'

REV	DATE	BY	DESCRIPTION
A	10-4-23	JRH	AS-BUILT PLANS

STATE OF MAINE
JAYSON R. HASKELL
No. 13202
LICENSED
PROFESSIONAL ENGINEER
10-4-2023

DM ROMA
CONSULTING ENGINEERS
P.O. BOX 1116
WINDHAM, ME 04062
(207) 310 - 0506

AS-BUILT: CHAMBERLAIN DRIVE

CHAMBERLAIN ESTATES
MANCHESTER DRIVE
WINDHAM, MAINE

FOR:
ROBIE HOLDINGS, LLC
PO BOX 1528
WINDHAM, ME 04062

20039	JOB NUMBER:
AS NOTED	SCALE:
10-4-2023	DATE:
SHEET 1 OF 4	
PP-1	